

Derby Industrial Museum

Railway Drawings Recording Form

Record number 1971-384/538

Previous Record number CATTELL
1070

Title BOROUGHT OF BURTON ON TRENT
IN THE COUNTIES OF STAFFORD & DERBY.

Brief Description

Map of Burton on Trent showing whole town up to 2 1/4 mile radius centred on site of new station.

Tables of: Reference to Breweries - 30 companies.
Details of Town & Council.
Public Buildings.

Proposed route of Burton/Stepenhill pedestrian bridge shown.

Permanent location DBYIM & room 49 & shelf: 118

Dimensions (mm) length: 720 width: 970

Material Paper

Condition good / fair / poor

Completeness complete / incomplete

Original drawing number

Company:

Scale: 1" = 220 yds

Person: J A Mason

Date: Sept 1879

Estate Agent & Surveyor
Burton on Trent

Place:

Burton on Trent

Classified category: 4. 721. 301. 205A, ~~205B~~, 75C

Recorder: MUY 23/5/03

219A	220A
219B	220B
219C	220C
221A	222A
221B	222B
221C	222C
221D	222D
	222E

Derby Industrial Museum

Railway Drawings Recording Form

Record number 1971-384/546.1

Previous Record number CATTELL
1083

Title

Brief Description

Plan showing route of railway
from Shoeburgh Wharf to Bond End Wharf
crossing under main line, & part of branch
off to James Street from Usbridge Street Junction.
Track line shows continuation from Bond End
across Fleet Green

Permanent location DBYIM & room 49 & shelf: 118

Dimensions (mm) length: 2870 width: 860

Material Tracing paper on paper on fabric

Condition good / fair / poor

Completeness complete / incomplete

Original drawing number

Company:

Scale: 1" = 1 CHAIN

Person:

Date: May 29th, 1880

Place:

Bewton on Trent.

Classified category: 4. 721. 30E. 221C, 221A, 221D 205A, 220C,

Recorder:

MAY 23/5/2003

Derby Industrial Museum

Railway Drawings Recording Form

Record number 1971-384/605.1-.36 ^{MULTI COPIES} Previous Record number CATTELL

Title MIDLAND RAILWAY
THE NEW RAILWAYS AT BURTON ON TRENT ACT 1878

Brief Description Plan of
FREEHOLD AND LEASEHOLD PROPERTY
belonging to the Representatives of
MR James Douglas.

County of Stafford, Parish of Burton on Trent.

Plan of land, roads, buildings between
New Street and Station Street including
Albert Place.

Landowners: Thomas Robinson, John Eaton.
Messrs of Anglesey leased to Daniel Gillespie
" " Miss Ann Cooper
" " Messrs Worthington
" " Burton Union Banking Co

Permanent location DBYIM & room 49 & shelf: 120

Dimensions (mm) length: 775 width: 510

Material Paper

Condition good / ~~fair~~ / ~~poor~~

Completeness complete / ~~incomplete~~ few torn edges

Original drawing number

Company: MR

Scale: 1" = 33 FEET Person:

Date: Oct 1879

Place:

Burton on Trent

Classified category: 4. 721. 301. 221 D

Recorder: *WJG* 31/10/2003

Derby Industrial Museum

Railway Drawings Recording Form

Record number 1971-384/293

Previous Record number

CATNELL
1029

Title

Brief Description

Large scale map showing line from
Bond End to Shobnall, shaded red, and
branches off it. Attached map shows
Act of 1874, solid red. Existing lines from
1836/60/64/78 in broken red.
Proposed route Burton Connecting Branch Act 1875
in fine red chain.

Adjacent properties, roads, watercourses and
landmarks shown.

Permanent location DBYIM & room 49 & shelf: 113

Dimensions (mm) length: 2730 width: 750

Material Paper on fabric

Condition good / fair / poor

Completeness complete / incomplete

Original drawing number

Company: M.R.

Scale: ~~2 1/2" = 1 CHAIN~~ 1" = 1 CHAIN Person:

Date: May 22, 1880


Place:

Burton on Trent.

Classified category: 4, 721, 301, 2206, 2209, 221A, 221C, 221D.

Recorder: *[Signature]* 21/12/2001

Plan 1874
Cutter 1836/1841
1875

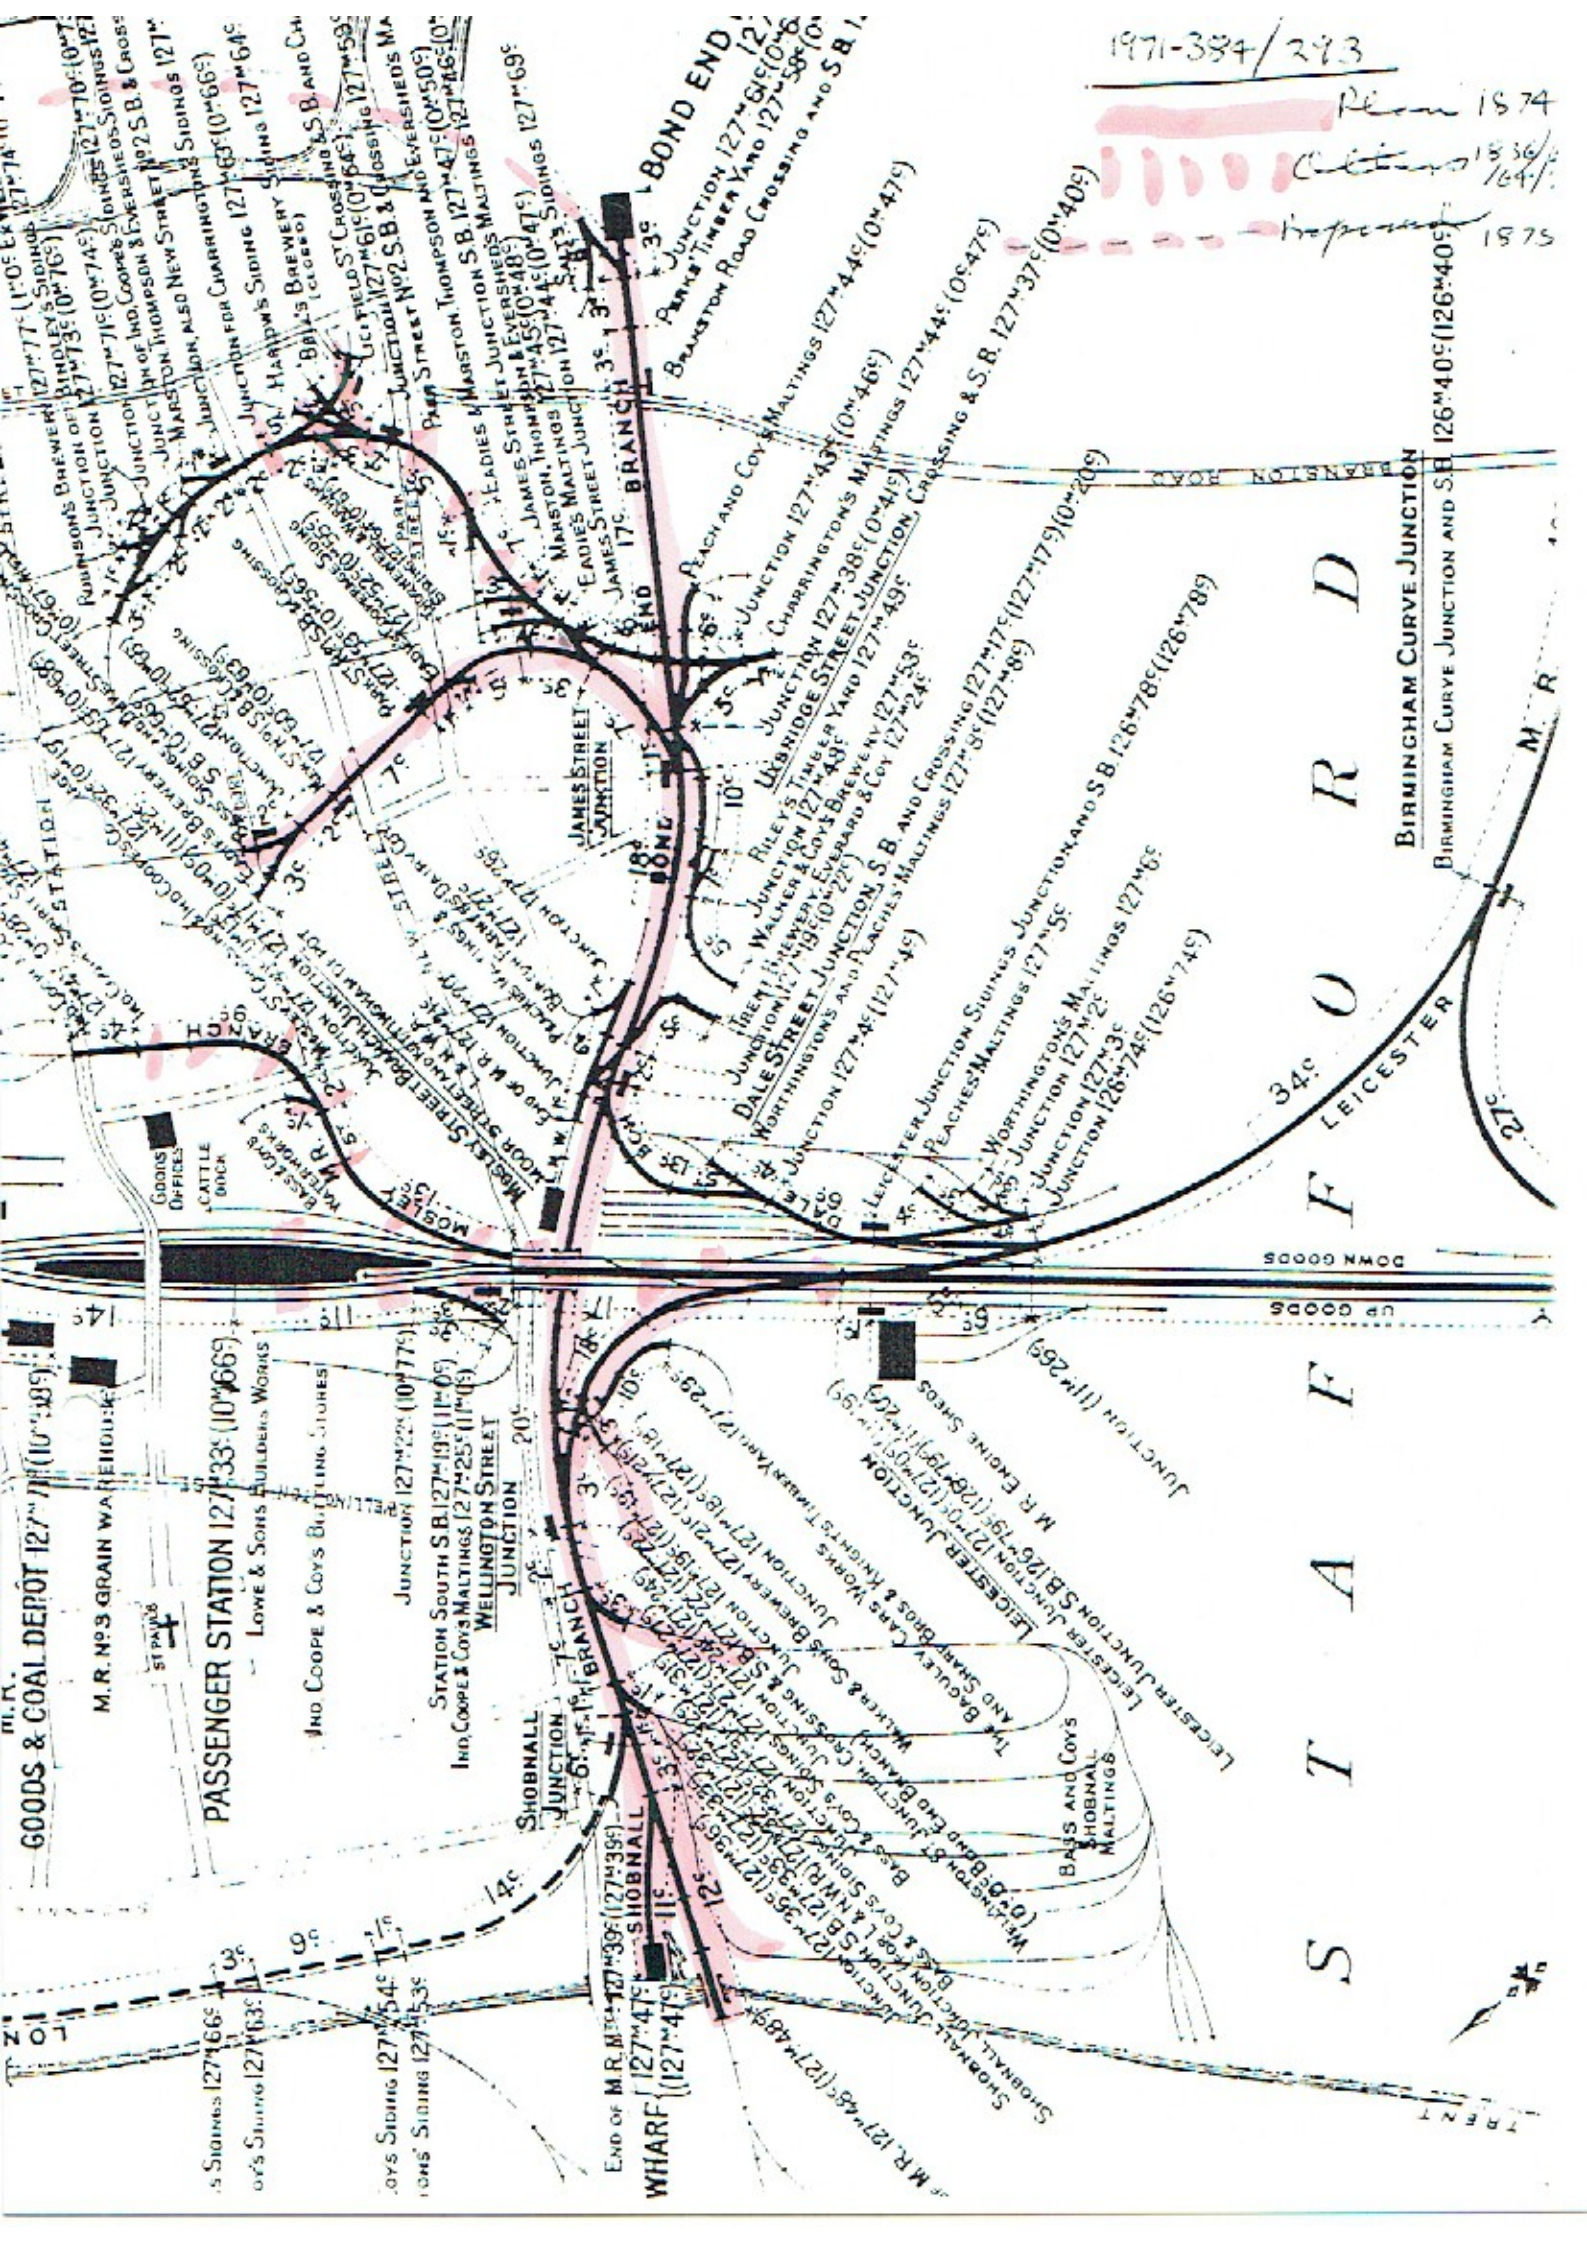

S T A F F O R D
LEICESTER

BIRMINGHAM CURVE JUNCTION
BIRMINGHAM CURVE JUNCTION AND S.B. 126°40' (126°40')

GOODS & COAL DEPOT 127°11' (10°49')
M. R. No. 3 GRAIN WAREHOUSE
PASSENGER STATION 127°33' (10°66')
IND. COOPE & COYS BUILDING SHEDS
IND. COOPE & COYS MALTINGS 127°25' (11°15')
WELLINGTON STREET
SHOBNALL JUNCTION 20°
SHOBNALL WHARF 127°41' (127°41')

STATION SOUTH S.B. 127°19' (11°09')
IND. COOPE & COYS BUILDING SHEDS
SHOBNALL JUNCTION 61°45' (14°38')

LEICESTER JUNCTION
M. R. ENGINE SHEDS
LEICESTER JUNCTION S.B. 126°19' (126°19')

THE BAULEY CARPS WORKS & KNIGHTS TIMBER YARD (127°19')
WALKER & SONS BREWERY JUNCTION 127°18' (127°18')

IND. COOPE & COYS MALTINGS 127°45' (127°45')

SHOBNALL JUNCTION 127°48' (127°48')

SHOBNALL JUNCTION 127°54' (127°54')

SHOBNALL JUNCTION 127°55' (127°55')

SHOBNALL JUNCTION 127°56' (127°56')

SHOBNALL JUNCTION 127°57' (127°57')

SHOBNALL JUNCTION 127°58' (127°58')

SHOBNALL JUNCTION 127°59' (127°59')

SHOBNALL JUNCTION 127°59' (127°59')

Derby Industrial Museum

Railway Drawings Recording Form

Record number 1971-384/291.1

Previous Record number

CATTELL
1029

Title

Brief Description

Good End Branch

Plan of part of town with branch off ~~the~~ MR line crossing James Street and towards Ardwick Street (Evedes Maltings, Brewery and Branch) other streets shown: Park Street, Lichfield Street, New Street, Unbridge Street. Premises shown: Evedes Maltings, Evedes Maltings, Thornwell & Warham, Binkley's Brewery, Evedes Brewery, Robinson & Co's Brewery.

Faint pencil line for new track from branch line (James Street Lane, Ballo, Evedes & Robinson.)

Permanent location DBYIM & room 49 & shelf 113

Dimensions (mm) length: 1000 width: 645

Material Paper on folio

Condition good / fair / poor

Completeness complete / incomplete

Original drawing number I 78

Company: MR

Scale: 1" = 100 ft

Person:

Date:

Place:

Entered on sheet

Classified category: 4.721.501. 221C, 221D, 221A, 222A.

Recorder:

1046 21/12/2001

END OF HAY BRANCH (127°52')


ALSO BASS ROAD

Wallingford

London

1971-384/291.1

New route

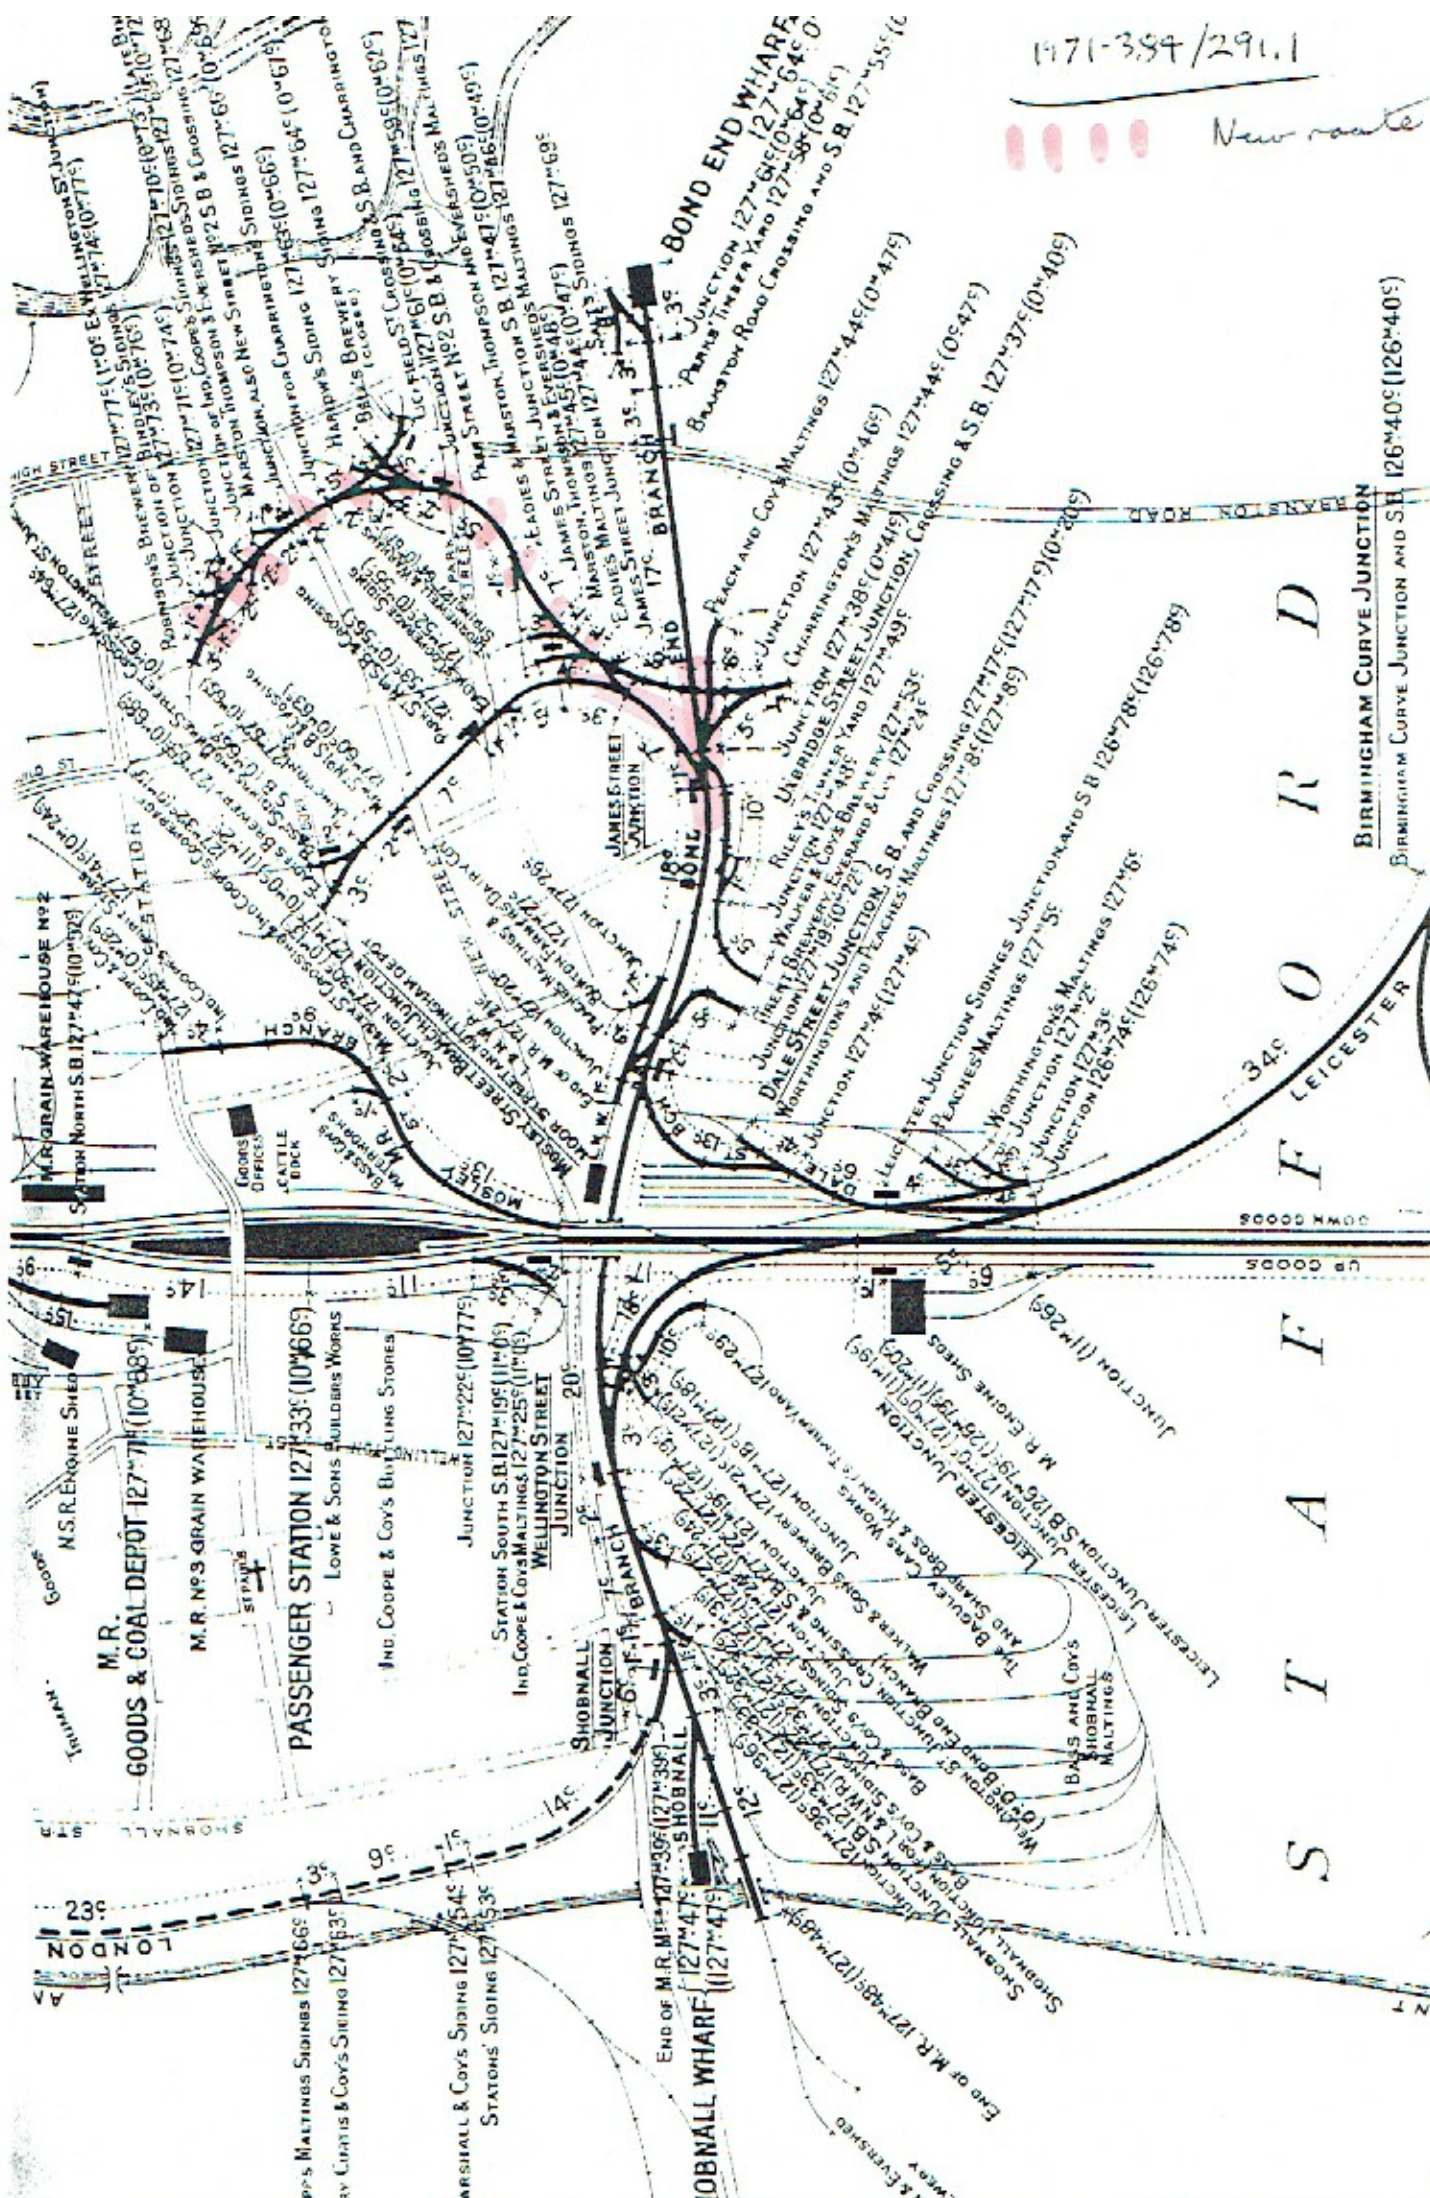

S T A I F O R D
LEICESTER
BIRMINGHAM CURVE JUNCTION AND S.B. 126°40' (126°40')
BIRMINGHAM CURVE JUNCTION

8000 YARDS

CB GOODS

8000 YARDS

LEICESTER

STATION

STATION

Derby Industrial Museum

Railway Drawings Recording Form

Record number 1971-384/291.2

Previous Record number

CATTELL
1024

Title

REDUCED PLAN
THORNEWELL & WARHAM

Brief Description

Plan of land between New Street and
Park Street/Highfield Street showing
buildings, lands, paths & roads.
Plots in red, green and blue.

Landowners:

The Marquess of Anglesey under lease to:-

Mr George Rosa Birchler.

Mr R Christian.

Mr R S Belcher.

M. T. Bass, M.P.

Mr John Birchley.

Mr James Green.

The Feoffees of B & T under
lease to Mr J O Keates.

John
Mr J Bell.

Permanent location DEYIM & room 49 & shelf: 113

Dimensions (mm) length: 395 width: 420

Material tracing paper

Condition good / ~~fair~~ / ~~poor~~

Completeness complete / ~~incomplete~~

Original drawing number

Company: MR

Scale: 1" = 1 chain

Person:

Date:

Place:

Buxton on Trent

Classified category: 4. 721, 301. 221D

Recorder:

WAG 21/12/2001

Derby Industrial Museum

Railway Drawings Recording Form

Record number 1997-5/ 329

Previous Record number MRP132/371

Title

Brief Description

Plan of parts of Burton on Trent
showing 3 proposed new routes, red ink,
Bond End, Park Street, Fleet Street area.

Permanent location DBYIM & room 49 & shelf: 72

Dimensions (mm) length: 1200 width: 1030

Material ~~Treated~~ ^{paper} on Paper on ~~galvan~~.

Condition ~~good~~ fair / poor

Completeness complete / ~~incomplete~~

Original drawing number

Company: MR

Scale: 1" = 1 CHAIN Person:

Date: 18 Feb - 1875

Place:

Burton on Trent

Classified category: 4.721.301. ~~221C~~ 221C, 221D, ?

Recorder: MMH 6/2/98