COUNTY OF RUTLAND

PARISH OF NORTH LUFFENHAM

Messrs Molesworth & Springthorpe. Siding Accommodation. Agt dated 1st 1920.

PROPOSED REVISION OF TURNTABLE
S. 5225/15. S.O. 7520/15

REV. J. BUSH (1246)

REV. ED. BROWN (1241)

LOADING STAGE MOVED FROM A TO B. S.O. 7568/15.

THOS PRIDMORE (1327)

TREES OF THOMAS HOTCHKIN & ORS (1282)

REV. ED. BROWN (1241)

J. MORRIS (1303)

REV. J. BUSH (1246)

DEVISEES OF SIR GILBERT HEATHCOTE, BART & OTHERS (2603)

REV. J. WELLER & OTHERS (1355)

RIVER CHATER

Parish Boundary

Air Ministry cable in 2" pipe, 4' below P.L. Laid Oct. 1918 SDGB 16087.

Luffenham Mill

Office

B Coal Kin

A Loading Stage

Goods Shed

PLATFORM

Up Line

Down Line

Loop Line

Sidings

Fire Hydrant

Street (1)

Street (2)

30 Miles

LUFFENHAM STATION

Luffenham Stathers S.B.

OIL TANK 20-S TAR TANK 30-S

S.D. 96/23 WORK COMPLETED
L. 8152/103 OCTOBER 10th 1923.
L.N. 2130/23.

SIDING ACCOMM FOR LUFFENHAM IRON Co S.D. 9992/18

REV. ED. BROWN (1241)

From South Luffenham

B.672.

To Kelton.

1" Water Pipe laid by Luffenham Iron Co 6th Jan. 1922. S.D. 12772/21. See ext. 28 in 4" with the Ballast Ploughs re pipe.

LONDON & NORTH WESTERN RAILWAY Co

DEVISEES OF SIR GILBERT HEATHCOTE, BART. & OTHERS (2893)

REV. JAMES BUSH (1246)

Air Ministry cable in 2" pipe, 4' below P.L. Laid Oct. 1918 SDGB 16087. Removed 1919 S.D. 6/1919

PARISH OF SOUTH LUFFENHAM

DEVSEES OF SIR G. HEATHCOTE, BART. & ORS. (2692)

Scale, 2 Chains to an Inch.

Links 100 0 1 2 3 4 5 10 15 20 Chains

Feet 100 0 100 200 300 400 500 1000 1500 Feet

Estate Agent's Office,
Midland Railway,
Derby.

COUNTY OF RUTLAND

PARISH OF NORTH LUFFENHAM

PARISH OF KETTON

KETTON, EDITH WESTON. KETTERING C.+I.C.o LIMESTONE QUARRIES. S.D. 9215/17.
Subjs Removed 4-7-44. Ref 1384.
See Dpt dated 20/46 with Rudolph Sater re. window rights. CDS8/13797.

DEVISEES OF SIR GILBERT HEATHCOTE BART. AND OTHERS (2693)

TREES OF THE NORTH LUFFENHAM CHARITY (1292)

JOHN MORRIS (1303)

RICHARD LUCAS (1290) FREEHOLD

REV. EDWARD BROWN (1241)

Broken, Down Side. C.I. Girder replaced by Sec.H. Girder Aug.'40 AD0 15685

JOHN MORRIS (1303)

AMELIA DE RIPPE (1255)

LORD NORTHWICK & ANOTHER (1307)

Air Ministry 2 O.H. cables over line 1948-49 C17315
Removed 1948

To Ketton.

B672

Culvert (17 chains)

No 58

No 59

No 60

No 61

Foster's Bridge

Foster's Bridge
5 IMP
49'

Parish Boundary

Boundary

RIVER CHATER

CHATER

From South Luffenham

5½

5½

Sheet 41

Sheet 43

31 Miles

REV. ED. BROWN (1241)

TREES OF BROWN'S HOSPITAL (2697) FREEHOLD

RICHARD LUCAS (1290) LEASEHOLD

JAMES PRIDMORE (1328)

DEVISEES OF SIR G. HEATHCOTE BART. & OTHERS (2693)

CHAS. W. WYCHE & WIFE (1363)

Two poles laid over stream with ends in bank (1 bank is Corp.). To stop notice serving Aug. 1887. C16533. Ref. quoted 2/2637.
Ref. 20/182

See Agreement dated 1 with Lord Lonsdale. C

BRIDGE No 58 AT 5M 9¼ CH. TWO 240 VOLT OVERHEAD CONDUCTORS FIXED TO WESTERN ABUTMENT ON 12-8-53. CORRES REF. L37330

PARISH OF SOUTH LUFFENHAM

Scale, 2 Chains to an Inch.

Links 100 0 1 2 3 4 5 10 15 20 Chains

Feet 100 0 100 200 300 400 500 1000 1500 Feet

Estate Agent's Office,
Midland Railway,
Derby.

COUNTY OF RUTLAND

PARISH OF KETTON

LORD NORTHWICK AND ANOTHER

1307

31 Miles

CHATER RIVER

Sheet 42

Sheet 44

CHAS. W. WYCHE & WIFE

1363

53/4

6 M.P.

6/4

Culvert (3'0" diam?) No 61A

Culvert (13" Square)

Culvert (1'8" diam?)

D.V. (Registered Boundary) 6/14

F.Hut

P.H.

Scale, 2 Chains to an Inch.

Links 100 0 1 2 3 4 5 10 15 20 Chains

Feet 100 0 100 200 300 400 500 1000 1500 Feet

Estate Agent's Office,
Midland Railway,
Derby.

COUNTY OF RUTLAND

PARISH OF KETTON

Siding Accommodation for Mr Rowe. Completed 27.10.04.
See Minute Plan 20560 (Rowe Buxton Lime Co)

See Ellis & Everard's letter of Oct 8 re building to be transferred to Hathern.
See Agreement dated December 6 1913

Platform Rebuilt 22-11-41

Service cables underground to S&T Issued 21-9-43 CDOR 17072.

3 INS. DIAM. WATER MAIN LAID UNDER LINE. SEE AGREEMENT DATED 21-8-52. WITH KETTON RURAL DISTRICT COUNCIL.

REV. J. H. NOYES (9344)
(Release of Over-Bridge at A)
FOR SUM OF £50 13-12-93
NO OTHER ACCESS TO BE PROVIDED.

THE VERY REV. R. STEVENS & HIS LESSEE (1348)

FRANCIS THOMPSON (1348)

SUSANNAH OSBURN (1313) FREEHOLD & COPYHOLD

J. W. GOODLIFFE (RESALE) (See Agt. 1442 G.)

GEORGE EDMONDS (9380) (M. & M. Conv.ce)

AMELIA DE RIPPE (1255)

S.D. 2884/12 E.1226/12 L.182 7/9/12
Mr T. H. Burroughes compliance Station Approach.
Land conveyed to M.R.Co. in 1843 coloured Red. See Mr Mc Williams letter March 1st 1912

Sdg and T.f removed Oct 41 C/10851

Land leased to Arthur William Miller Agt dated 2.3.37. C/1468.
Cancelled 8/54
Land fenced in to Rly along Boundary 4/57 Correct K.38636.

Midland Hotel

Mid-Lincs. E.S. Co. overground cable. Agt dated 7.11.35 laid 22.10.35 See Agt. C/10168

Waddson & Bull

32 Miles

Maltkiln

Stock Shed

Offices

W.M.

CRANE

S.B.

L.C.

PLATFORM

Kilns

Quarry (Limestone)

Kilns

Allotments

Ketton S.B.

From Ketton

From Tixover

To Colly Weston

From Ketton

No 402

7 M.P.

OLD PUMP

T.L.C.

Road

Buxton Lime Co's Kilns

25 Yds Siding Removed leaving Points as from Plan 12940 C/10851
Agreement dated 19-5-13 with the Northants Lime Co Ltd. C. 15978

See Agt (30-7-37) with Erica Hutton for acc. of Footpath. C/1468

See Agmt. with Buxton Lime Firms Co Ltd dated 1-1-1891. and memorandum with Mr. T.C. Molesworth dated 12-11-41. C/15978.

REV. BALDWIN WAKE (1352)

LORD NORTHWICK & ANR (1307)

THOMAS GREEN & WIFE (1268)

LORD NORTHWICK & ANOTHER (1307)

Mr Gibson's application to open out roadway to connect gas main S.D 3662/14 E.6386/14

485 LEV.

Stock 43

Stock 45

Scale. 2 Chains to an Inch.

Links 100 0 1 2 3 4 5 10 15 20 Chains

Feet 100 0 100 200 300 400 500 1000 1500 Feet

Ketton

Estate Agent's Office,
Midland Railway.

COUNTY OF RUTLAND

PARISH OF KETTON

L.M.S. Railway 4 ft 6 ins Single Line

Ketton Portland Cement Co Ltd's Sidings
added 5-4-30

LORD NORTHWICK AND ANOTHER

(1307)

33 Miles

Sidings

Sidings

Sidings

Fog Hut

Fog Hut

Signal Box

11000v Overhead Cables erected by Mid Lincs. Supply Co 17-7-33 Corres 29/4918

SEE NOTE ON SHEET 46

Sheet 44

Sheet 46

3/4M Concrete 8" pipe under Br. 3' deep, 6" conc. cover in centre of arch 15-7-45 M.R.O.E. 10917

No 63

Culvert (Pipe Drain) No 63A

County and Parish Boundary

COUNTY OF NORTHAMPTON

PARISH OF EASTON ON THE HILL

Scale, 2 Chains to an Inch.

Links 100 0 1 2 3 4 5 10 15 20 Chains

Feet 100 0 100 200 300 400 500 1000 1500 Feet

Estate Agent's Office,
Midland Railway,
Derby.

COUNTY OF RUTLAND

PARISH OF KETTON

COUNTY OF NORTHAMPTON

PARISH OF EASTON ON THE HILL

Siding for the Marquis of Exeter. Work completed 26.9.00

Parish Boundary

LEV. 330

Fence

Ditch

Culvert (3'0" Diameter) No 642

Culvert (3'0" Diameter) No 643

Tinwell Crossing S.B.

330 932

Gate House

To Tinwell

To Tinwell

Flood Bank

34 Miles

From Easton-on-the-Hill

From Easton-on-the-Hill

83

84

1

3

4

7

8

SCHEDULED FOR SURFACE WORKING OF CLAY AND LIME UP TO RED HATCHING.
CORRES. PET. D. 32273. 3/3/55.

LORD NORTHWICK & ANR. (1307)

THE MARQUIS OF EXETER AND HIS TRUSTEES

S.D. 9413/13 E 1638/413
East of Exeter's sidings

S.D. 9586/14 E 1929/1014
York Lincolnshire Ironstone Co.

(3284 1705) COVENANTS FREEHOLD

Scale, 2 Chains to an Inch.

Links 100 0 1 2 3 4 5 10 15 20 Chains

Feet 100 0 100 200 300 400 500 1000 1500 Feet

Estate Agent's Office,
Midland Railway,
Derby.

COUNTY OF RUTLAND

PARISH OF TINWELL

COUNTY OF LINCOLN

PARISH OF ALL SAINTS

34 Miles

County & Parish Boundary

County & Parish Boundary

Sheet 46

Culvert (2. 0 diam.r) No 64E

Culvert (2. 0 diam.r) No 64E

Culvert (2. 0 diam.r) No 64E

Culvert (6. 0 diam.r) No 64E

8¾

9¼

9¼

9¼

Qu. C

Pilot

Pilot

RELEASE AT HEIGHT OVER 14'-6" AGREEMENT DATED 18:12:58. MO. 186.

H. T. GILCHRIST 1273

Fencing & Boundary Posts erected Dec^r 1911. S.D 2438/11

Mid-Lincs Elec. Supply Co. Cable under line of 4 steel piping (4 duct) 4" conc. 4" covering of concrete. Laid Dec 30 to Engineers Dept. 18.1.41.

9^m 59 0^{1/2}^s S. 40920.

To Stamford & Peterboro

To Stamford

Fm No. 64 F.

Post Path

From Easton on the Hill

STAMFORD CORPORATION & OTHERS 1346

Parish Boundary

Sheet 48

Trench Cable laid 1946 Purpose Distributing Mains of 9^m 3.3^c (Complex System)

COUNTY OF LINCOLN

PARISH OF ALL SAINTS

BOROUGH OF STAMFORD

See Agreement dated 19th July 1914 No 89. Book 24.
Mr Miles. Timber Merchant, to raise Co's Wall
Ordered 27-6-40 - 14719.

See Agreement dated 5.11.03 concerning a cable belonging to the Urban Electric Supply Co C.11651

As to Land taken by Stamford Corporation See P.H. 5897

S.D. 2438/41 E 2418/408 L.R.T. 164/38
11th Chain's compliment of gallows at sidings

Urban Electric Supply Co's Cable Agt. dated 9.9.38 C.11651

Grass Verge 30 Ewt Crane No 106 removed 30-12-41 AD0 10151/55

Brick wall to Miles property replaced by dwarf wall with Wel. Fence on Top. 13-7-41 A14719

Say 4 22 K.V. removed AD0 16851 Plan 146/51

Cable to S.M.S. house 2 class under road & 18 under remainder Wor No (DOR 1951

Joining connection for Mr Miles Work completed 2-2-49

Engine Shed 4 part jacking removed 20-5-59 AG 10151

THE MARQUIS OF EXETER AND HIS TRUSTEES (2704 2707 COVENANTS FREEHOLD)

TREES OF BROWN'S HOSPITAL (2697)

STAMFORD CORPORATION & OTHERS (1346)

THE MARQUIS OF EXETER & ANR (1654)

35 Miles

RIVER WELLAND

EHT Cable laid through Culvert by Mid Lincs Supply Co May 1935 Ref. 2064/35

County & Parish Boundary

Culvert (4'-3" diam.) No 64

Culvert (3'-6" diam.) No 64A

Culvert (3'-6" diam.) No 64B

Culvert (3'-6" diam.) No 64C


































Mrs Muncup's complaint re damage to property through vibration
Westholme St Martins S.O 5617/4 E 4650/414.

BOROUGH OF STAMFORD

COUNTY OF LINCOLN

PARISH OF ST GEORGE

THE MARQUIS OF EXETER AND HIS TRUSTEES (2704 2707 COVENANTS FREEHOLD)

WARDENS &c OF BURGHLEY'S HOSPITAL (2698)

Trespassing on Parapet of Bridge 68. Proposed Barbed Wire Etc. work completed Feb 3rd 1922
S.O. 13847/21 E 6854/421

G.P.O. Underground Cable laid Sept. 1937 2ft. from parapet & 2ft. deep. A11573

Easement dated 19-4-40 for light & windows overlooking Cole property from building between points X.X. Rent 10/- p.a.

Electric cable renewed 14th June 1923, by The Urban Electric Supply Co.
S.O. 1111/23.

4" Gas Main of Stamford & St Martins Gas Co. laid in concrete in jack arch spandrel Oct. 1937 C11618

Medium Voltage Electric Cable Laid Over Tunnel By East Midlands Electricity Board During March 1955. Corres. Ref. S.38435.

11000 Volt Electric Cable Laid By East Midlands Electricity Board 25-6-53 Corres Ref S 37249

RICHARD WEBSTER (2730)
ROWLAND R. MINGAY (1713)
THOS MILNER & HIS MORTGEE (1300)
Wm MILLS (1299)
ELIZ. & SUSANNAH MILLS (1298)
THE STAMFORD UNION (1347)

STAMFORD STATION (G. N. R.)

27" STORM WATER DRAIN FOR NEWAGE ENGINEERS. LAID APRIL 1975. CORRES. REF. CE/B/1000/759. 10M. 70½c.

STAMFORD

J. ATTER & ANR. (1228)

St Martin's Church

Grave Yard

St Martins Grave-Yard (Disused.)

Malthouse

Malthouse

Stamford Union Workhouse (Disused.)

Allotment Gardens

NEWAGE ENGINEERS LIMITED

Mid-Lincs E.S. Co. 2nd overground electric line. Agt. dated 6-13-35.

Approximate Line of 33000 Volt O/H Line. And over Line for the Mid-West England Electricity Scheme of the Central Elect. Board S 216-51. (2nd Circuit)

This existing exists (1952)

Stamford June. S.B.

~~36 Miles~~

Engine Shed

Coal Stage

WATER CRANE

Goods Shed G. N.

Signal Office

Gas Holder

Hotel

Inn

Borough Boundary

County & Parish Boundary

STAMFORD TUNNEL No 68

BARNACK ROAD

To Barnack

To Wansford

Burghley Park

River Welland

Great Northern Railway

Stamford S.B. (G.N.R.)

W. & CHAS. J. ROBERTSON (1329)
JOHN SAVIDGE & OTHERS (1332)
REV. E. B. WERE (2731)

ROBERT TINKLER (2724) See Plan with Lease (2437) permitting them to use land for riding, Allso
G. HUDSON (2713)
DEVISEES OF R. HUNT (1288)

THE MARQUIS OF EXETER & HIS TRUSTEES (2704 2707 COVENANTS FREEHOLD)

THE MARQUIS OF EXETER AND HIS TRUSTEES (2704 2707 COVENANTS FREEHOLD)
(Also Easement for Stamford Tunnel.)

REV. P. WILSON & HIS WIFE (1358)

THE STAMFORD UNION (1347)

Lithgow Elec. Supply Co. Cable over Br. 24 & 39 C11895 Agreement dated 1-3-33

2" Cable laid by Urban Electric Supply Co. Ltd. 1st Aug. 1933 S.O. 1083/33

The Gas Main Extension A-B-C Laid By The East Midlands Gas Board On 22-10-54 Corres Ref S 35022

4" Gas Main Extended By East Midlands Gas Board During March 1954. Corres. Ref. S.37766.

Bridge No 68 (Stamford Tunnel) Superstructure Carrying Great North Road Reconstructed In 1953 For Details And Service Pipes, Cables Etc See Drawing No 51/LC. 198A. Corres Ref: S.34982

St Sewer Pipes &c Agmt dated 25th Mar 1901.

PARISH OF ST MARTIN STAMFORD BARON

COUNTY OF NORTHAMPTON

Scale, 2 Chains to an Inch.

Links 100 0 1 2 3 4 10 15 20 Chains

Feet 100 0 100 200 300 400 500 1000 1500 Feet

Estate Agents Office, Midland Railway, Derby

COUNTY OF NORTHAMPTON

PARISH OF ST MARTIN STAMFORD BARON

PARISH OF BARNACK

(FORMERLY PARISH OF PILSGATE)

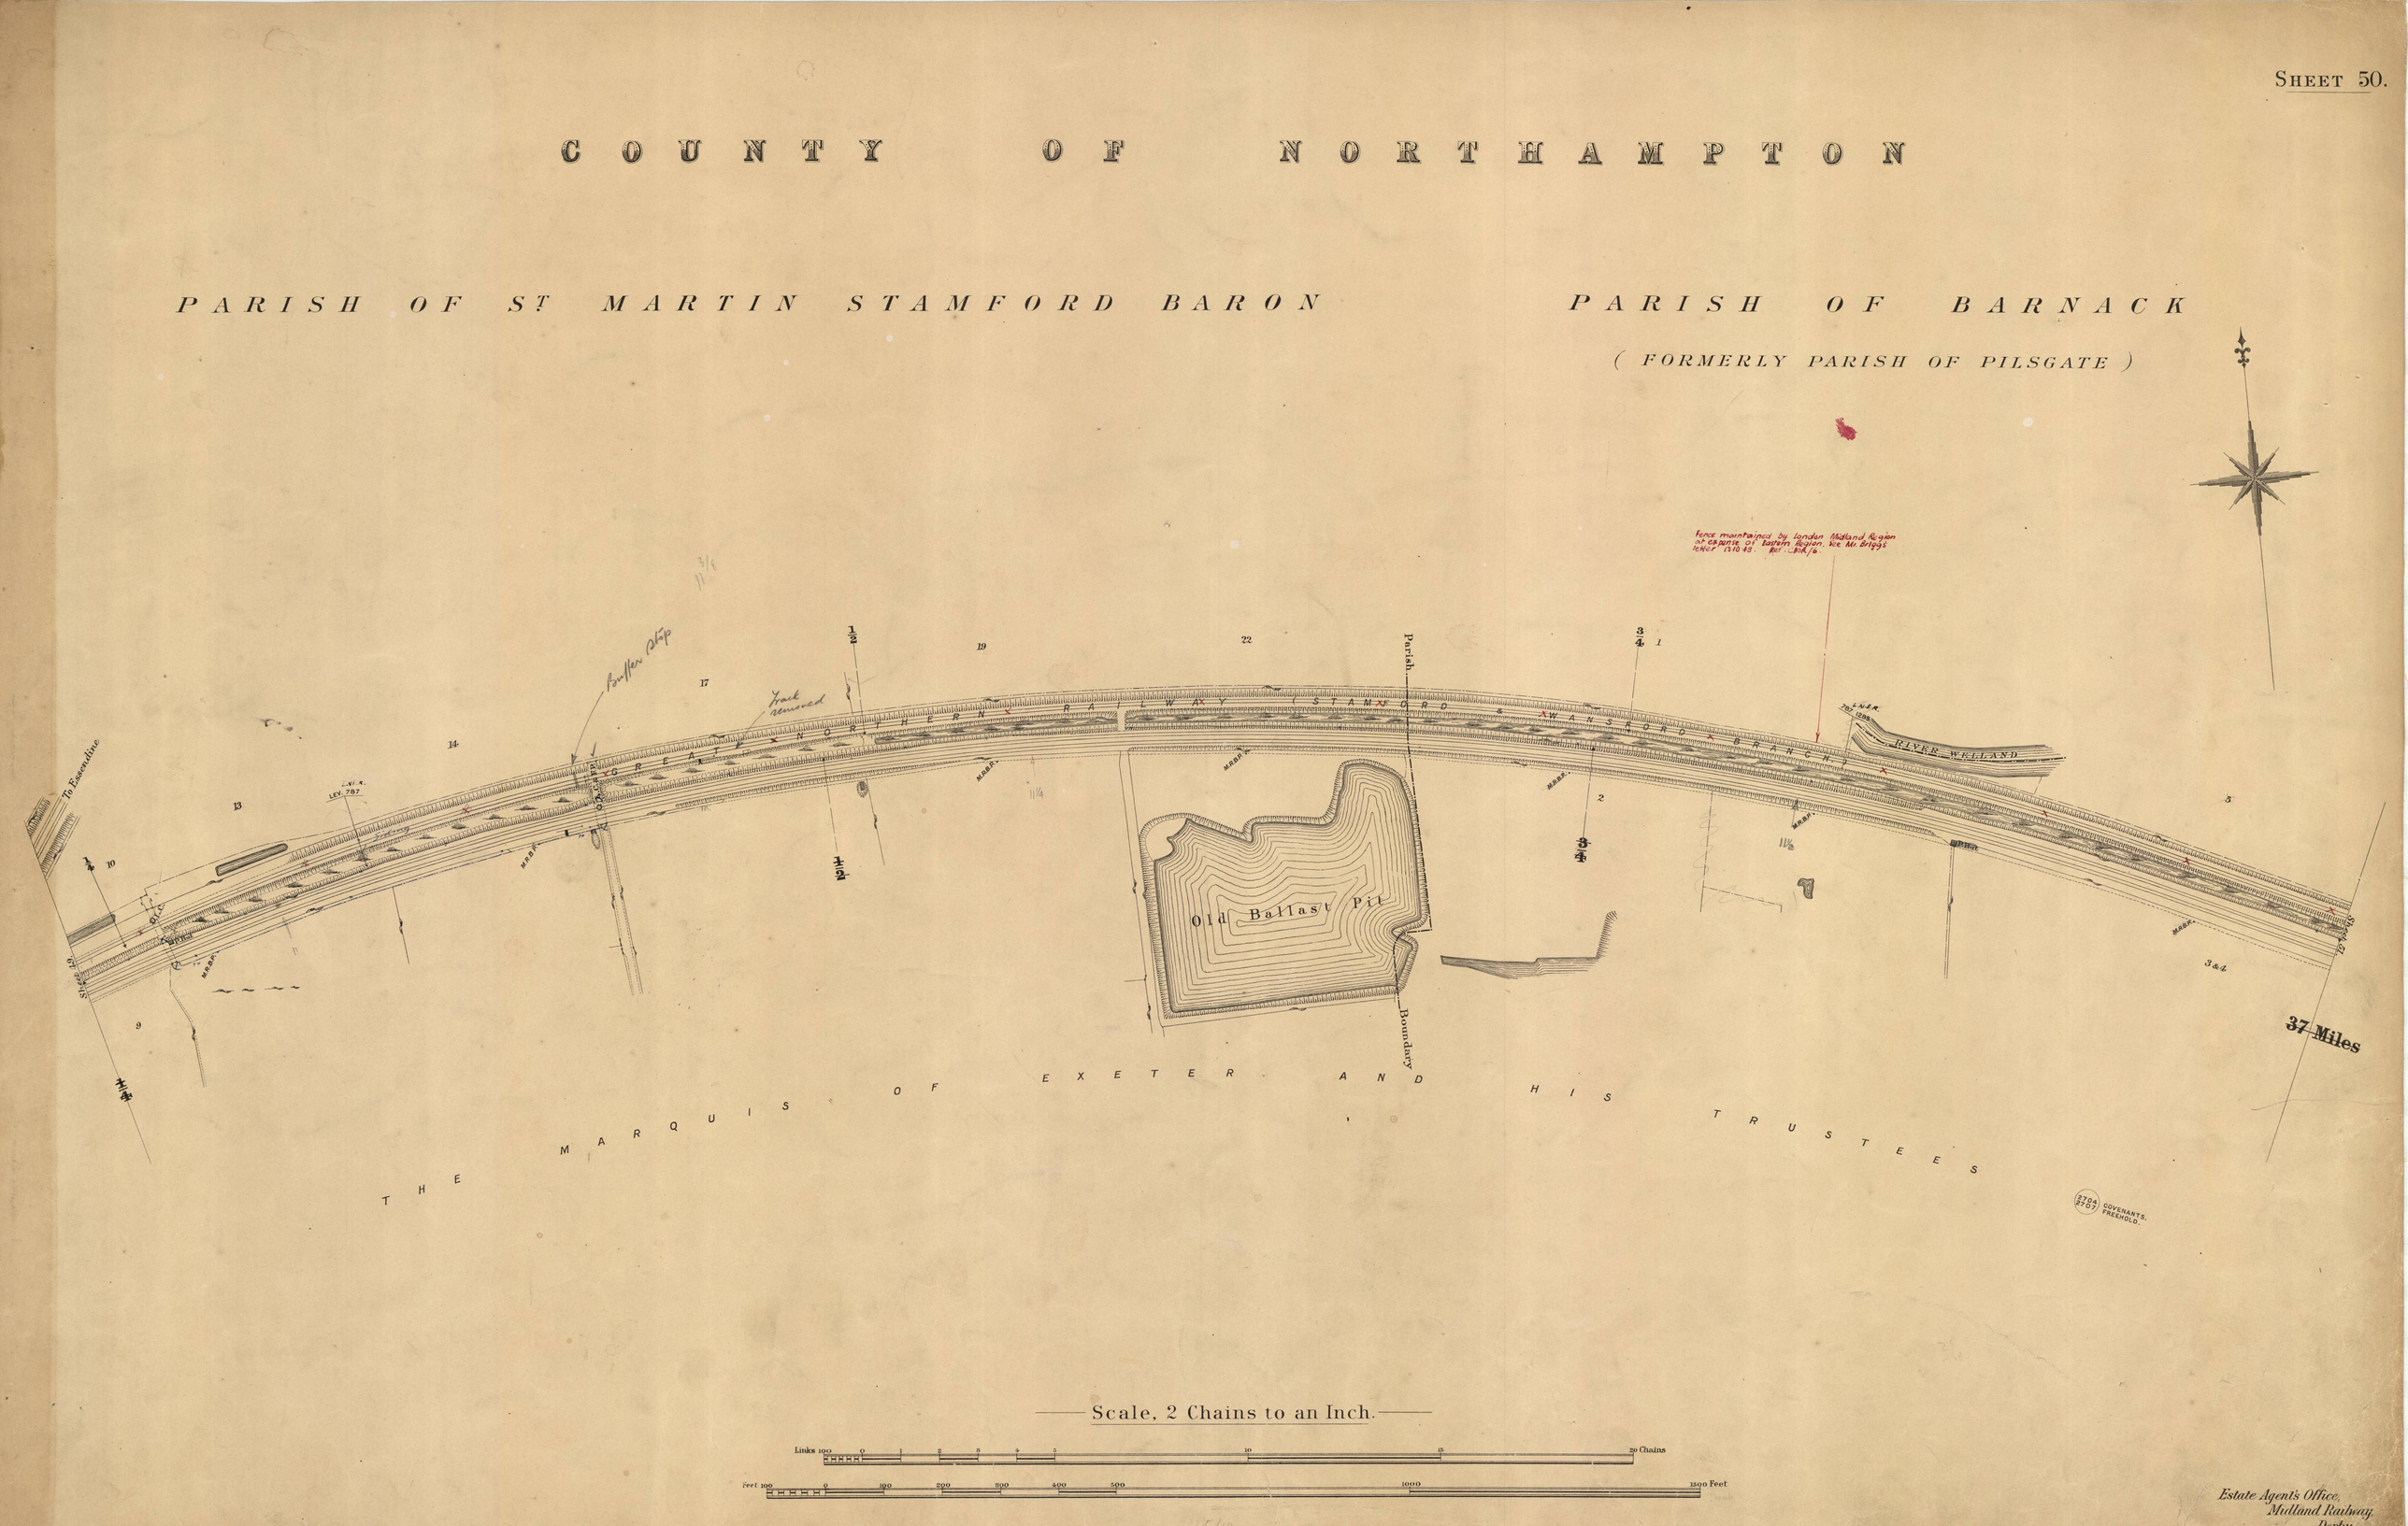

Scale, 2 Chains to an Inch.

Links 100 0 1 2 3 4 5 10 15 20 Chains

Feet 100 0 100 200 300 400 500 1000 1500 Feet

Estate Agent's Office,
Midland Railway,
Derby

COUNTY OF NORTHAMPTON

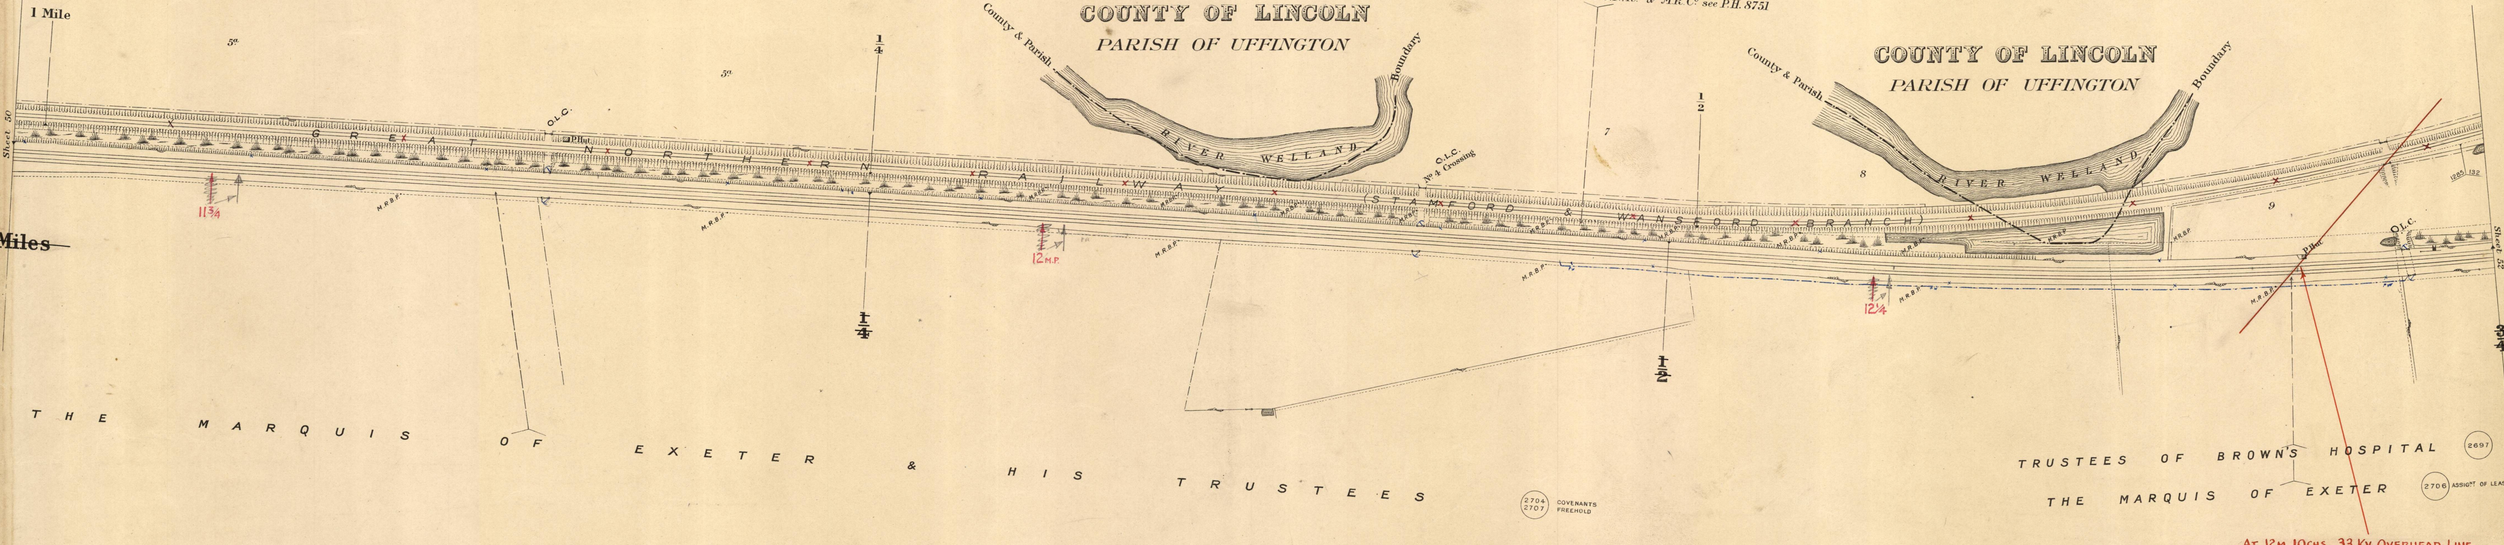

PARISH OF BARNACK

(FORMERLY PARISH OF PILSGATE)

Scale, 2 Chains to an Inch.

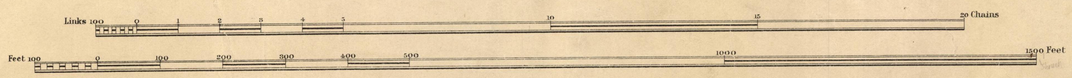

Estate Agent's Office,
Midland Railway
Derby.

COUNTY OF LINCOLN

PARISH OF UFFINGTON

SIR JOHN TROLLOPE (1351)

TRUSTEES OF BROWN'S HOSPITAL (2697)
THE MARQUIS OF EXETER (2706) ASSIGNT. OF LEASE

THE MARQUIS OF EXETER & HIS TRUSTEES (2704 2707) COVENANTS FREEHOLD

Rebuilding Down Platform Work Completed 11.6.07. See Minute Plan No 28164.

11kV Overhead Electric Line erected Jan. 1937 C.10546
Cable restrung E.M.E.B. Feb. 1960. U/A1281.

240 VOLT O/H ELECTRIC LINE AT 12m. 76c TO STATION HOUSE
7.1.75. REF. 1000/762

To Uffington Parish Boundary

County and

38 Miles

From Uffington

Parish Boundary

Uffington S.B.

No 71.

No 71A

No 70.

No 2 (G.N.R.B.) 41794

No 2

132 LEV.

12¾

15 MP

UFFINGTON & BARNACK STATION

Bridge superstructure removed and opening filled in 31.10.42. ABC 15372

To Wansford

Sidings to Barnack

From Pilsgate

Foot Path

Formerly

THE MARQUIS OF EXETER AND HIS TRUSTEES (2704 2707) COVENANTS FREEHOLD

THE STAMFORD & ESSENDINE RAILWAY Co (10183) (M. & M. Cons'd.)

COUNTY OF NORTHAMPTON

PARISH OF BARNACK

Scale, 2 Chains to an Inch.

Links 100 0 1 2 3 4 5 10 15 20 Chains

Feet 100 0 100 200 300 400 500 1000 1500 Feet

Uffington & Barnack

Estate Agent's Office,
Midland Railway,
Derby.

COUNTY OF NORTHAMPTON

PARISH OF BARNACK

THE MARQUIS OF EXETER AND HIS TRUSTEES — 2704 2707 COVENANTS FREEHOLD

WILLIAM CLOSE AND ANOTHER — 1249

REV. H. CHARLES MARSH & OTHERS — 2712

PARISH OF BAINTON

Parish Boundary

No 72

To Tallington

From Barnack

P.L.C.

Fog Hal.

P. Hal.

39 Miles

23 24 26 28 31 32

Sheet 52

Sheet 54

Scale, 2 Chains to an Inch.

Links 100 0 1 2 3 4 5 10 15 20 Chains

Feet 100 0 100 200 300 400 500 1000 1500 Feet

Estate Agent's Office,
Midland Railway,
Derby.

COUNTY OF NORTHAMPTON

PARISH OF BAINTON

REV. ROBINSON ELSDALE AND HIS TRUSTEES (1262)

SIR JOHN TROLLOPE (1361)

From Tallington

Bainton Crossing

Gate House

Culvert (1 9 diam.) No 72A

Culvert No 72

P. Hut

242.660

B.P.

O.L.C

Sheet 53

Sheet 55

From Bainton

Foot Path

To Bainton

SIR J. TROLLOPE (1351) COPYHOLD.

THE MARQUIS OF EXETER (2705) ENFRANCHISEMENT.

5" DIAM. RISING MAIN. BARNACK (SEWER) & 2" WATER MAIN.
R.D.C. SEWERAGE SCHEME.
CORRES. REF. B. 40087

1/4 1/2 3/4

2 6 5 8 11 13 14 16 19

40 Miles

Scale, 2 Chains to an Inch.

Links 100 0 1 2 3 4 5 10 15 20 Chains

Feet 100 0 100 200 300 400 500 1000 1500 Feet

Estate Agent's Office,
Midland Railway,
Derby.

COUNTY OF NORTHAMPTON

PARISH OF BAINTON

SHEET 55.

S.D. 6032/14. E 9509/414. L.A. 3602/14
Cleaning out Flaxit Dyke between C and D
Flax Pit Dyke cleaned out by Lord Kesteven about July 1914
it is next to be cleaned out between A B by the Midland Rly Co
See Mr Clay's letter of 11.1.15 and Lord Kesteven's Agent's letter (Mr Edward Swallow)
of January 8th 1915. S.D 6032/14 E 9509/414 L.A. 3602/14.

S.D. 1121/15 (File No 1) E. 38/419
Helpston Ballast Pit. Flooding. See Mr Miles letter to Mr Briggs, Dec 13th 1915

THE RIGHT HONBLE J.H. BARON KESTEVEN Agt 32 K RESALE

THE RIGHT HONBLE JOHN HENRY BARON KESTEVEN & HIS TRUSTEES (1783) M. & M. Conveyd.

Land leased to Board War Agriculture Committee Agt. dated 18-7-44. 5a 0r 14½ P.

Footpath Abandoned & diverted as shown on Plan No. 53. LPB: 171A. Corres. Ref. H. 34140. Feb. 1955.

Fence

Flaxit Dyke

To West Deeping

Stile

Path

Tipped Land

Helpston Ballast Pits

The L.N.E.R. have granted T.E. Conington & B.J. Duncomb permission to fish in these pools. See Agreement dated 20-4-36

TRUSTEES OF WILLIAM E. HUTCHINSON ESQ. (8022 8124) ENFRANCHISEMENT. COVENANT. (M. & M. Conveyd.)

See agreement dated 22/8/37 with Mr Trollope-Bellew concerning shooting. S.6330.

Land purchased from Robert Grimshaw. Agt 28.11.49.

Foot Path

Water

Ballast Face

Fence

Present Siding No 2

Siding under Water

Water Ballast Face

104 yds

122 yards Fence

Electric Power

Engine House demolished 23-6-39 Ag 1429

42 yds

Land leased to Charles E. Naylor Agt. dated 8.5.39. M. 12881.

Parish Boundary

Stream (Roman Road)

King Street

Helpston

Culvert No 72A

Culvert No 72B

Culvert No 72C

Fence & Gate maintained by M.R.Co S.D.V. 1043/22.

See Agreement with the Central Electricity Board (dated 20.7.38) re electric line across Railway

See adjoining Sheet

New P.& R. fence erected between A & B on Co's side of Ditch 27-2-37 C9682

Cricket Bat Willow Trees planted 1916.

Sidings transferred to Traffic Dept. See Minute Plan No 26367 4.7.1912

Land leased to Monks Engineering Co. Agt 27.10.43. Cancelled Ref 17649.

Formerly Parish Boundary

M.R.Co's Boundary edged Green

FORMERLY PARISH OF ASTON

SIR JOHN TROLLOPE BART. (1351)

JOHN NOTTINGHAM, THE MARQUIS OF EXETER, (130 1308) COPYHOLD —DO— (2705) ENFRANCHISEMENT

Fencing Bainton Green Crossing Between Helpston and Uffington S.D. 5722/14 L.A. 2291

Bainton Green Crossing No 73

Estate Agents Office Midland Railway Derby.

Scale, 2 Chains to an Inch.

PARISH OF HELPSTON

From Bainton

To Miles

East Ballast Sidings S.B.

163 15 C 14

COUNTY OF NORTHAMPTON

PARISH OF HELPSTON

S.D. 543. E.6298/409. LA4. 2928/09.
Maxey Crossing. Drainage.

From Derby

From York

9

18

Sheet 55

Sheet 57

Culvert (1-6 Arch)

MRBP

MRBP

MRBP MRBP

41 Miles

7

5

10

16 MP

Maxey Crossing G.N.R.

Culvert (3-0 Arch) M.R.P.M.R.B.P.

R.A.M.

DIKE

BULL AND GOODENOUGH (1244)

EARL FITZWILLIAM

BULL & ANR (1244)

To Helpston

Peterborough R.D.C. Water main. Laid 6-3-29. A.R.R. 19312.

S.D. 4967/3. E. 10750/413.
Parish Council complaint re fencing. Maxey Crossing

Scale, 2 Chains to an Inch.

Links 100 0 1 2 3 4 5 10 15 20 Chains

Feet 100 0 100 200 300 400 500 1000 1500 Feet

Estate Agent's Office,
Midland Railway,
Derby.

COUNTY OF NORTHAMPTON

PARISH OF HELPSTON

Trap to Sdng. laid April 38 C10656 Plan 2487

4" Water Main of Peterboro R.D.C. laid under Crossing Nov. 1937 C10670

Approx position of G.P.O. Telegraph line 112 4... Ref 19534

To Peterborough

6,600 Volt Cable laid under Crossing 29-1-35 by Peterboro' Corp.n See Ref C5785/35

82 Miles

Helpston West S.B.

Railway Hotel

REVD CHARLES MOSSOP (1302)

GREAT NORTHERN RAILWAY

Culvert (1'6" diam.) No 1758

Culvert (1'0" diam.) No 736

Ram Dike

WILLIAM THOMPSON & ORS. (1330)

DANIEL WEBSTER (1354)

Arbor field Mill

From Helpston

12 Miles

S.M.Ho.

Goods Shed

Granary

Land leased to R. Jackton Esq. dated 21-3-34 - C15113.

Helpston East S.B.

HELPSTON STATION

Alterations to track completed May 43. Ref. 10851/174.

MASTER ETC. OF CHRIST'S COLLEGE CAMBRIDGE (2700)

Maintenance of fences on approach to level crossing

E 7170/413

S.D. 4645/13

Green edge shews M.R.Co.s boundary.

See Agreement dated 2nd May 1914. No 68 Book 24. The Peterborough Co.s Ct. Signboard

Scale, 2 Chains to an Inch.

Links 100 0 1 2 3 4 5 10 15 20 Chains

Feet 100 0 100 200 300 400 500 1000 1500 Feet

Helpston Station

Estate Agent's Office, Midland Railway, Derby.

COUNTY OF NORTHAMPTON

PARISH OF ETTON

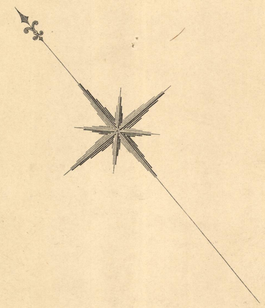

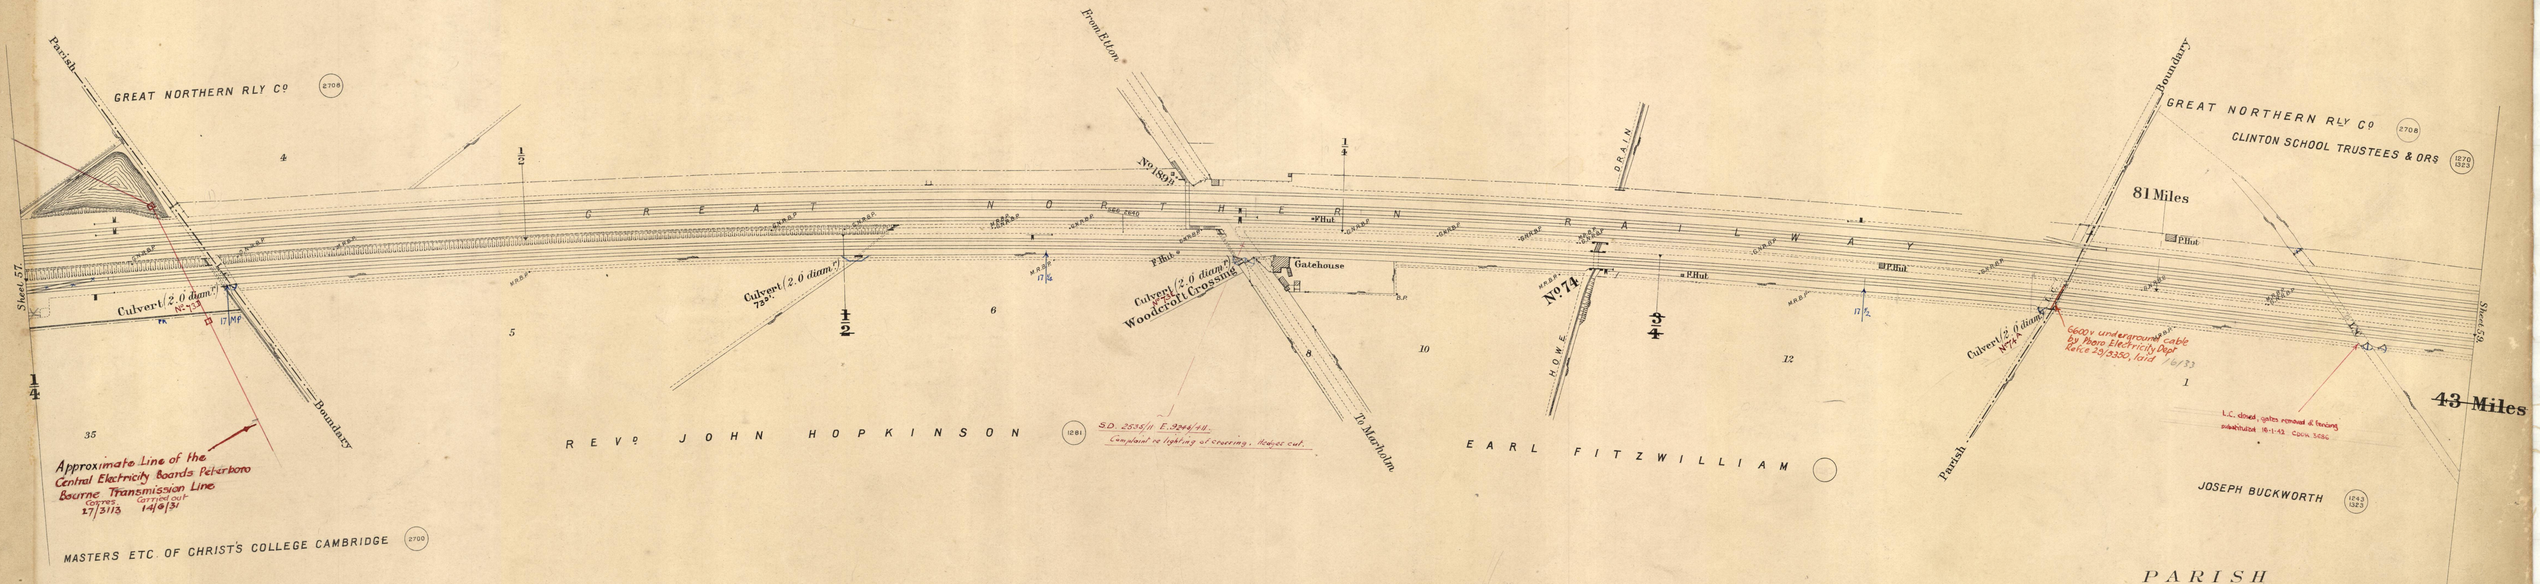

Scale, 2 Chains to an Inch.

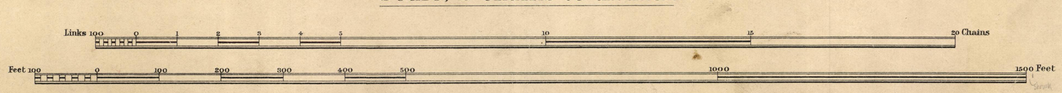

Estate Agent's Office,
Midland Railway,
Derby.

COUNTY OF NORTHAMPTON

PARISH OF GLINTON

PARISH OF MARHOLM

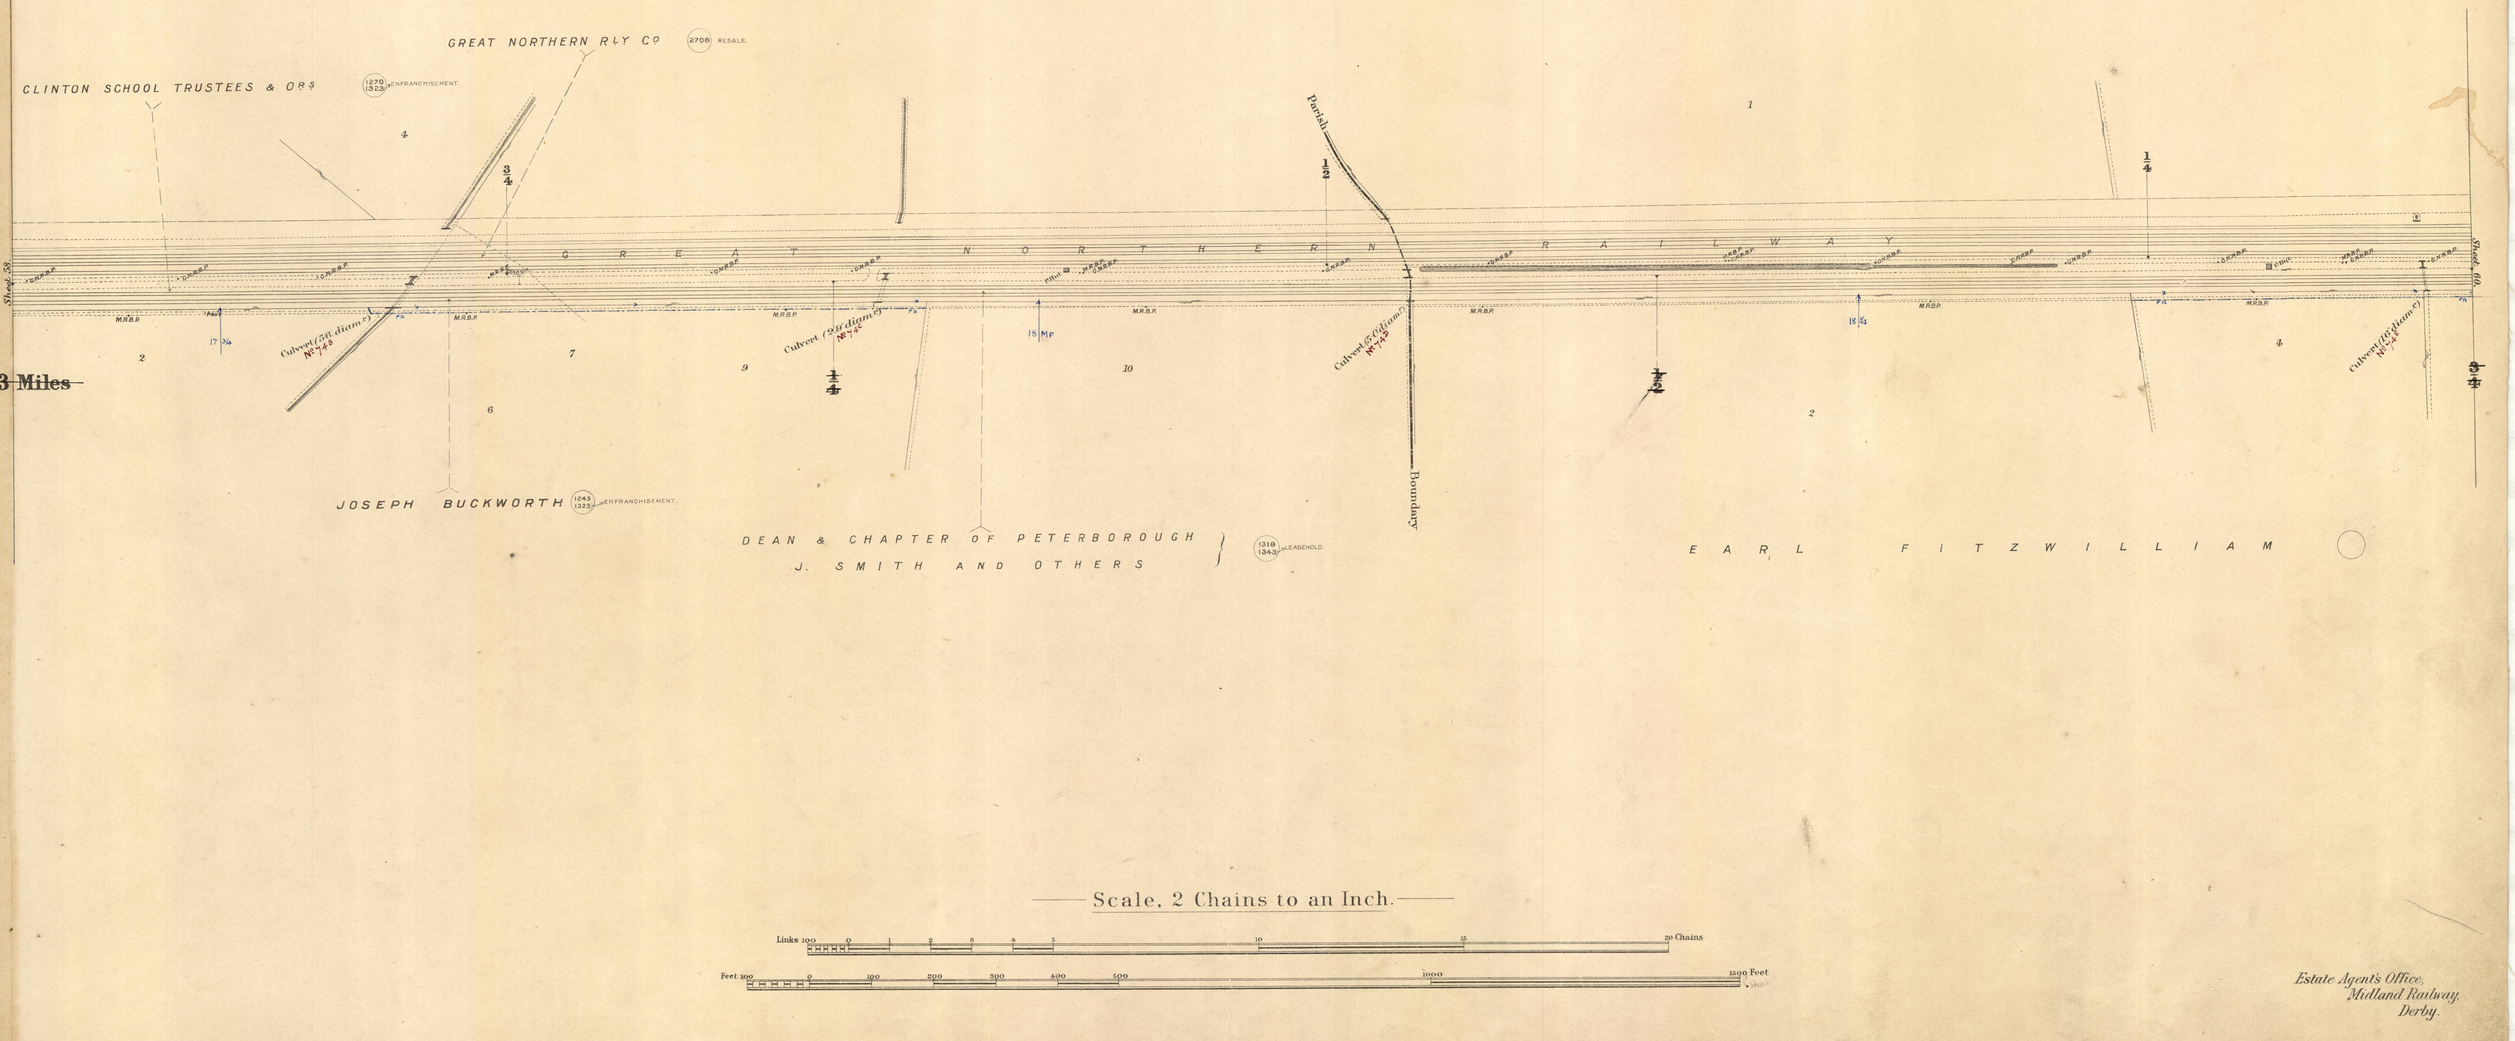

~~43 Miles~~

Scale, 2 Chains to an Inch.

Links 100 0 1 2 3 4 5 10 15 20 Chains

Feet 100 0 100 200 300 400 500 1000 1500 Feet

Estate Agent's Office,
Midland Railway,
Derby.

COUNTY OF NORTHAMPTON

PARISH OF WERRINGTON

(FORMERLY PARISH OF PASTON)

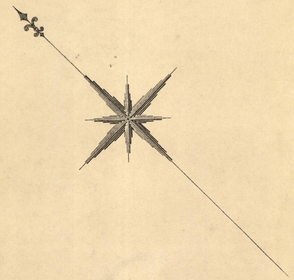

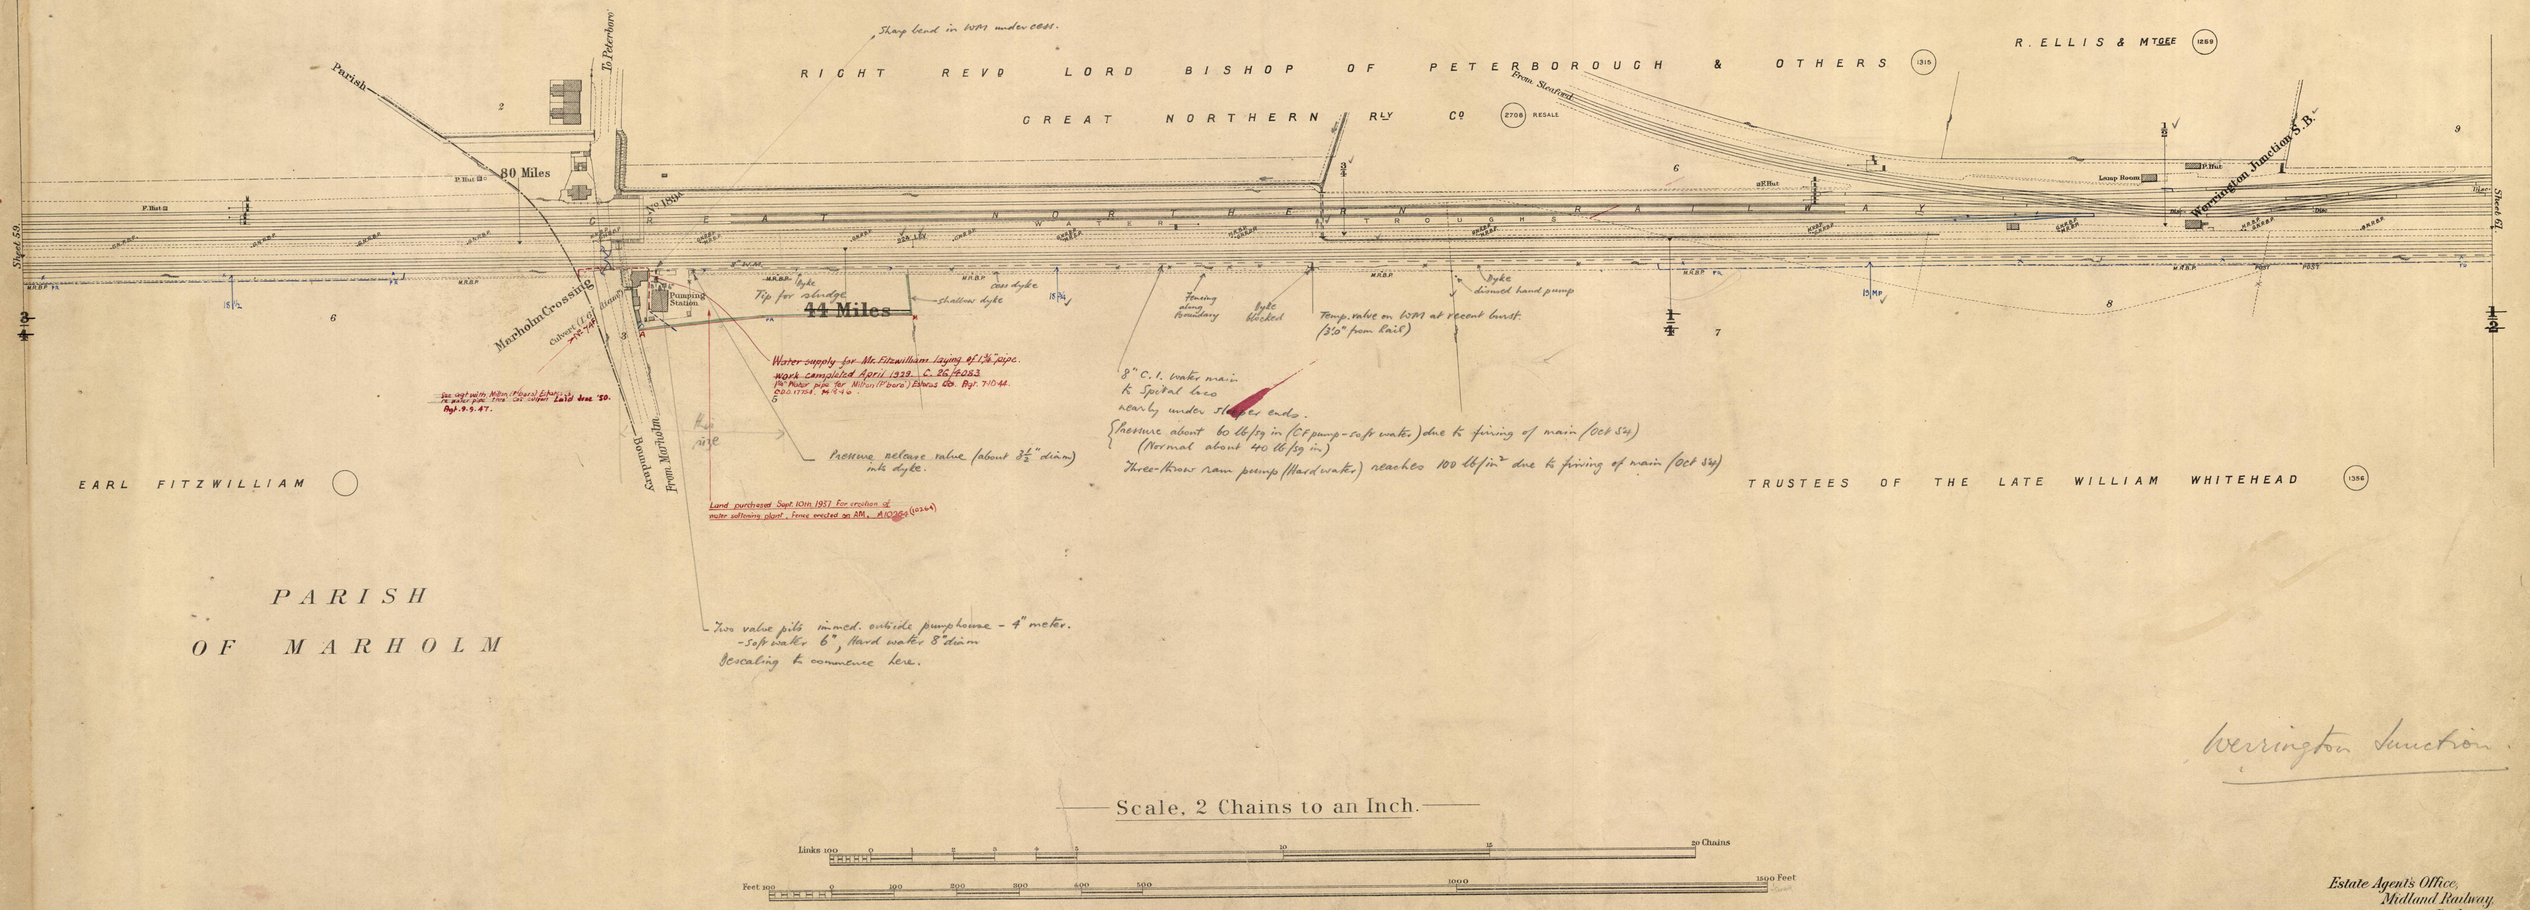

Scale, 2 Chains to an Inch.

Estate Agent's Office,
Midland Railway,
Derby.

COUNTY OF NORTHAMPTON

PARISH OF WERRINGTON
(FORMERLY PARISH OF PASTON)

PARISH OF WALTON
(FORMERLY PARISH OF PASTON)

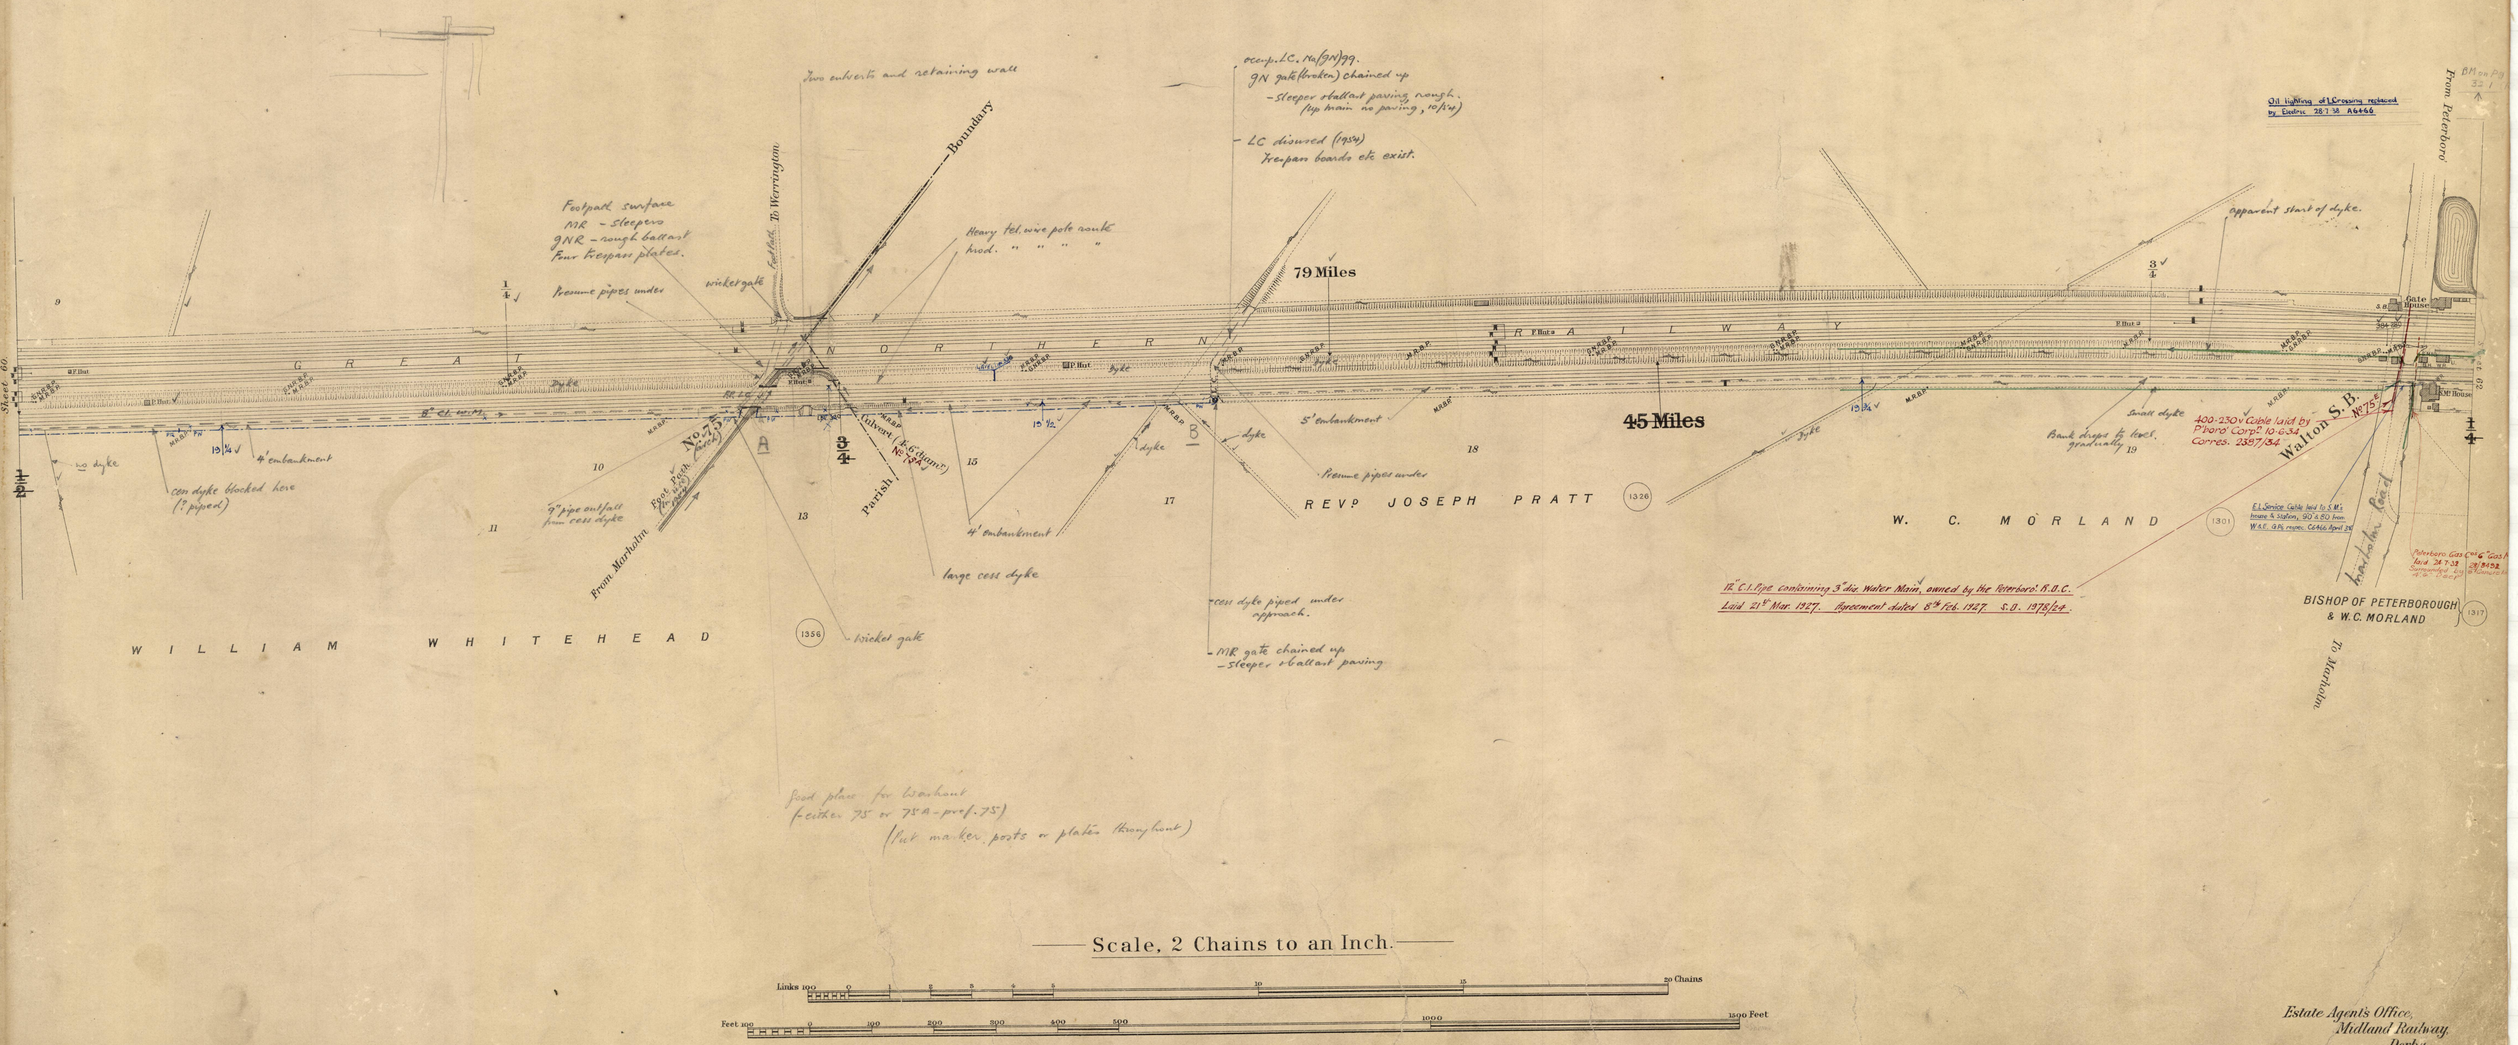

Estate Agents Office,
Midland Railway,
Derby.

COUNTY OF NORTHAMPTON

PARISH OF WALTON

(FORMERLY PARISH OF PASTON)

PARISH OF ST JOHN BAPTIST PETERBOROUGH

WALTON

Sage's Lane L.C.

WALTON STATION

Closed Dec 1913
Buildings & Platforms removed 1934.

BISHOP OF PETERBOROUGH AND W. C. MORLAND (1317)

EDWD COTTERILL (1281)

W. C. MORLAND (1301)

EARL FITZWILLIAM

BISHOP OF PETERBOROUGH & ANR (1316)

EARL FITZWILLIAM

FEOFFEES OF TOWN LANDS ETC. OF PETERBOROUGH (1324)

Gilstrap's Maltings

78 Miles

46 Miles

Boundary

8" water main, manholm to Spital runs under Up Platform just below surface - Portion of Platform wall retained to support it.

Walton Stn.

Scale, 2 Chains to an Inch.

Links 100 0 1 2 3 4 5 10 15 20 Chains

Feet 100 0 100 200 300 400 500 1000 1500 Feet

Estate Agents Office,
Midland Railway,
Derby.

SOKE OF PETERBOROUGH

SYSTON & PETERBOROUGH.
SHEET 63.

CITY AND BOROUGH OF PETERBOROUGH

PARISH OF PETERBOROUGH WITHIN

FORMERLY

COUNTY OF NORTHAMPTON

FORMERLY

PARISH OF ST JOHN THE BAPTIST

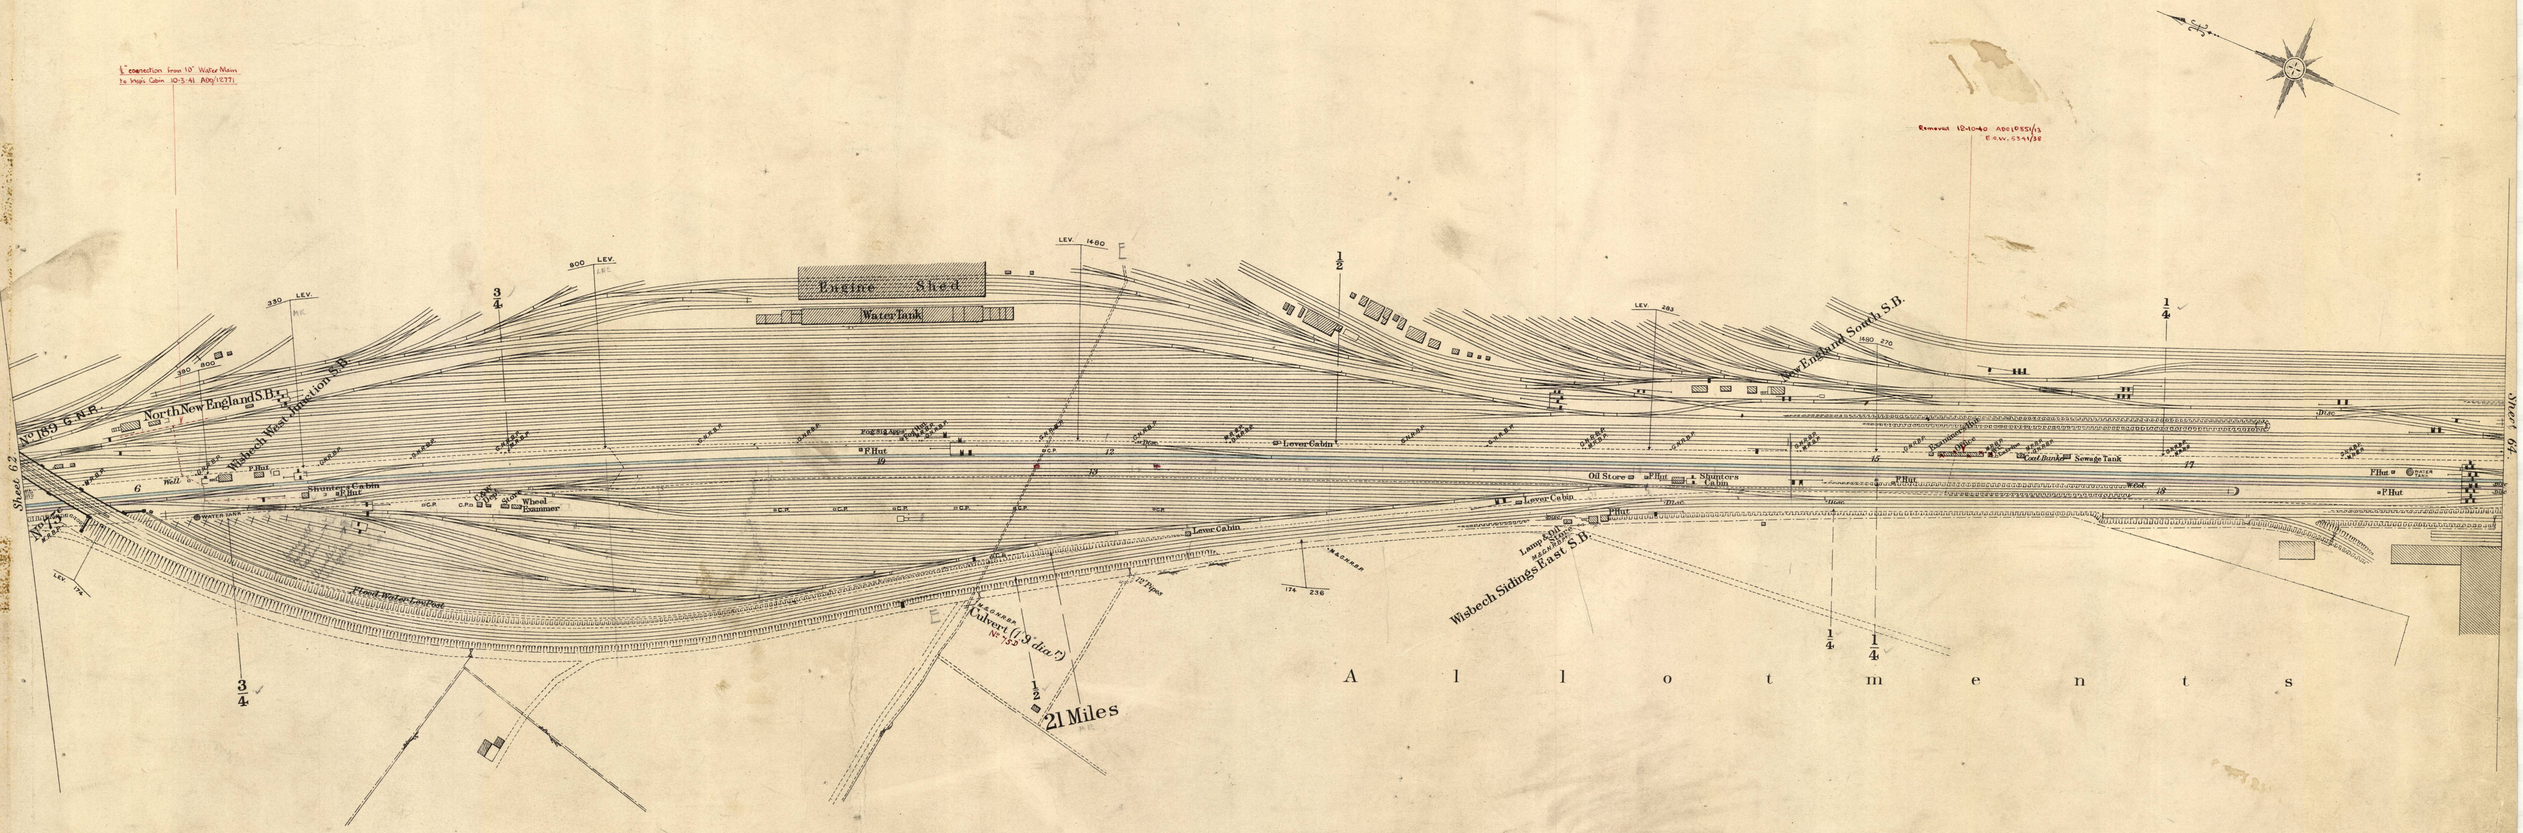

Scale, 2 Chains to an Inch.

Links 100 0 1 2 3 4 5 10 15 20 Chains.

Feet 100 0 100 200 300 400 500 1000 1500 Feet.

SURVEYED Nov. 1920.

Estate Agents Office
Midland Railway.

SOKE OF PETERBOROUGH

CITY AND BOROUGH OF PETERBOROUGH

PARISH OF PETERBOROUGH WITHIN

FORMERLY

COUNTY OF NORTHAMPTON

FORMERLY

PARISH OF ST JOHN THE BAPTIST

SYSTON & PETERBOROUGH.
SHEET 64.

PETERBOROUGH STATION
(G. N. R.)

3⅞" dia. Steel pipe containing electric cable laid by the Post Office. February 1928. 5'-0" from North parapet, 12" deep. S.O. 4490/28. E.M. 24/427.

6" Gas Main laid by Peterborough Gas Co about 1909. No Agreement traced

6" Water Main laid by Peterborough Corporation in Sept 1915 under Agreement dated Sept 16th 1914

8" Water Main. Peterborough Corporation. Date laid not known, no Agreement traced

77 Miles

Westwood Bridge

Eastfield S.B.

Stage

No 188

Westwood Junction S.B.

Engineering Works
(JOS. DAKIN & SONS. PERKINS LTD)

0 Miles

Engineering Works
(AUBLET, HARRY & Co LTD)

WESTWOOD ROAD

Allotments

Peterborough Corporation maintain road surface & footpaths under Agreement 21st Nov 1907.

Fence set back 20' from road for length of 83' N.R. arched in recess, widest gate set back with fence. April 28 C8748

15 Ft. strip sold to Co-Op. March '28 C8748

Land leased to Peterbro' Dist. Co-op. Soc. Area of land 2R 5P. Rent dated 13-5-35 Sold to Co-Op. Agreement dated 2-2-38. C.8748

Electric cables laid by Peterborough Corporation in 1930 under Agreement dated March 11th 1931.

Electric cable laid by the Peterborough City Electricity Dept. Work completed October 1924. S.O. 2105/24.

GREAT NORTHERN RAILWAY

DOWN RECEPTION LINE

Spital Junction S.B. (G.N.)

Spital Bridge

No 187

Workshops

22 Miles

Office
Mess Room
Lamp Room

Spital Bridge S.B.

Foundry
Shed

Machine Shop

Fitting Shop

Sheer Legs

Offices

Cattle Pens

Anglo American Oil Depot

Cooking Stove

Shunter's Cabin

Allotments

Demolished 24-6-33 A/C 10851

MAYORS WALK

MIDLAND ROAD

WILLIAMSON AVE

CLIFTON AVE

PERCIVAL AVE

HOLDICH STREET

S. Thompson

Widening of Spital Bridge and diversion of Loco Footpath Work Completed
Bridge opened for Traffic August 4th 1922.
S.O. 1238B/22 R/1706 & 2022/1+2a

Peterboro' Corporation Cable shown in blue see M. Darby letter of 16-9-33 & cancel from dated 9-10-33.

Altered in Thick Blue Line 15-12-33 as carried out - See letter from Electricity Dept, Peterboro. dated 6-12-33

100 Ft. Loco House chimney removed 22-8-39

Engine T.T. and pits removed 9-3-40 Plan No 174/39 A13175

A1 of 30" Sold to Peterboro' Dist. Co-operative Society See Agreement dates 28-8-27

Scale, 2 Chains to an Inch.

Links 100 0 1 2 3 4 5 10 15 20 Chains.

Feet 100 0 100 200 300 400 500 1000 1500 Feet.

SURVEYED Nov, 1920.
Estate Agent's Office
Midland Railway,
Derby.

SOKE OF PETERBOROUGH

CITY AND BOROUGH OF PETERBOROUGH

PARISH OF PETERBOROUGH WITHIN

FORMERLY

COUNTY OF NORTHAMPTON

FORMERLY

PARISH OF St JOHN THE BAPTIST

SYSTON & PETERBOROUGH.

SHEET 65.

Peterborough, Riverside Wharf. Sleeper Stage removed March 14th 1923. E.H.B. 4.23.

S.D. 886/23.

PETERBOROUGH STATION (G. E. R.)

Boundary

Travelling Crane

Travelling Crane

Saw Mills

STATION ROAD

Urinal

Two Electric cables (one 3300 v., one telephone pilot cable) laid 1-1-33 by Beds., Hunts & Cambs Elec. Supply Co.

Fletton Road Junction S.B.

Siding connection removed.

Siding repaired 12.8.38 Order P1737 - firm's cost £180 ACE/B165A Plan 145/38

Transforming Station

T.S.S.U. Shed (Formerly Goods Shed)

LONDON Rd

ROAD

Footpath

No. 184

No. 183

Woodstone S.B.

To London.

LNER W/s Bridge widened 1924.

DOCK (Disused)

No. 73

Reconstructed 1933 See Plan No 1519

Alterations by Military Dec 1940 C6874
A Stile removed B Pen gate replaced by wicket gate
C Stile replaced D Pen gate wired up.

Former County Parish

From Northampton

Central Electricity Board's Overhead Cables. See Consent Form dated 10-3-31

Central Electricity Board's Cables laid in steel angles Plan No. 11. Agt. 14-10-32

Siding for South East England Electricity Comm.

Pulverised Fuel Station

Gasholder (3 G diam.)

Gasholder (Disused)

Retort House

Coke Ovens

Exhauster House

Purifiers

Tar Tanks

Condenser House

Meter House

Oil Store

Oil Store

Oil Store